
















 


File name: H:\CAD\660 Asbuilts\Nurse Call Asbuilts 9-2-05\ACAD-71EY001.dwg Last Plotted: 05/22/2012 @ 09:53 By: vhaslcrvjanj

ELECTRICAL SHEET INDEX	
SHEET NO	DRAWINGS
EY001	SHEET INDEX, SYMBOL SCHEDULE
EY101	NOT USED
EY102	NOT USED
EY103	NOT USED
EY104	MICU AREA – PHASE I NURSE CALL PLAN
EY105	NOT USED
EY106	SICU AREA – PHASE I NURSE CALL PLAN
EY107	NOT USED
EY108	TELEMETRY/CCU AREA – PHASE I NURSE CALL PLAN
EY109	ACUTE MED AREA (2W) – PHASE I NURSE CALL PLAN
EY110	ACUTE MED AREA (2E) – PHASE I NURSE CALL PLAN
EY111	ACUTE MED AREA (2E) – PHASE I NURSE CALL PLAN
EY112	NOT USED
EY113	SURGERY CLINICS (3W) – PHASE I NURSE CALL PLAN
EY114	SURGERY CLINICS (3E) – PHASE I NURSE CALL PLAN
EY115	SURGERY CLINICS (3E) – PHASE I NURSE CALL PLAN
EY116	NOT USED
EY117	HOPTEL AREA (4W) – PHASE I NURSE CALL PLAN
EY118	FOURTH FLOOR CLINICS (4E) – PHASE I NURSE CALL PLAN
EY119	WARD 3A AREA – PHASE I NURSE CALL PLAN
EY201	BUILDING 14 – COMMUNICATIONS PLAN
EY202	BUILDING 14 – COMMUNICATIONS PLAN
EY203	BUILDING 14 – COMMUNICATIONS PLAN
EY204	BUILDING 1 – COMMUNICATIONS PLAN
EY205	BUILDING 1 – COMMUNICATIONS PLAN
EY206	BUILDING 1 – COMMUNICATIONS PLAN
EY207	BUILDING 1 – COMMUNICATIONS PLAN
EY208	BUILDING 1 – COMMUNICATIONS PLAN
EY209	BUILDING 3 – COMMUNICATIONS PLAN
EY401	COMMUNICATIONS ROOMS DETAILS
EY601	NURSE CALL SYSTEM CABLE SCHEDULE AND DETAILS
EY602	NURSE CALL COMMUNICATIONS DETAILS
EY603	NURSE CALL COMMUNICATIONS DETAILS

DEFINITIONS	
NOTE: ALL DEFINITIONS MAY NOT BE USED.	
INDICATED: THE TERM "INDICATED" REFERS TO GRAPHIC REPRESENTATIONS, NOTES, OR SCHEDULES ON THE DRAWINGS, OTHER PARAGRAPHS OR SCHEDULES IN THE SPECIFICATIONS, AND SIMILAR REQUIREMENTS IN THE CONTRACT DOCUMENTS. WHERE TERMS SUCH AS "SHOWN", "NOTED", "SCHEDULED", AND "SPECIFIED" ARE USED, IT IS TO HELP THE READER LOCATE THE REFERENCE, NO LIMITATION ON LOCATION IS INTENDED.	
DIRECTED: TERMS SUCH AS "DIRECTED", "REQUESTED", "AUTHORIZED", "SELECTED", "APPROVED", "REQUIRED", AND "PERMITTED" MEAN "DIRECTED BY THE ENGINEER", "REQUESTED BY THE ENGINEER", AND SIMILAR PHRASES.	
APPROVE: THE TERM "APPROVED", WHERE USED IN CONJUNCTION WITH THE ENGINEER'S ACTION ON THE CONTRACTOR'S SUBMITTALS, APPLICATIONS, AND REQUESTS, IS LIMITED TO THE ENGINEER'S DUTIES AND RESPONSIBILITIES AS STATED IN GENERAL AND SUPPLEMENTARY CONDITIONS.	
FURNISH: THE TERM "FURNISH" IS USED TO MEAN "SUPPLY AND DELIVER TO THE PROJECT SITE, READY FOR UNLOADING, UNPACKING, ASSEMBLY, INSTALLATION, AND SIMILAR OPERATIONS."	
INSTALL: THE TERM "INSTALL" IS USED TO DESCRIBE OPERATIONS AT PROJECT SITE INCLUDING THE ACTUAL "UNLOADING, UNPACKING, ASSEMBLY, ERECTION, PLACING, ANCHORING, APPLYING, WORKING TO DIMENSION, FINISHING, CURING, PROTECTING, CLEANING, AND SIMILAR OPERATIONS."	
PROVIDE: THE TERM "PROVIDE" MEANS "TO FURNISH AND INSTALL, COMPLETE AND READY FOR THE INTENDED USE."	
INSTALLER: AN "INSTALLER" IS THE CONTRACTOR OR AN ENTITY ENGAGED BY THE CONTRACTOR, EITHER AS AN EMPLOYEE, SUBCONTRACTOR, OR SUB-SUBCONTRACTOR, FOR PERFORMANCE OF A PARTICULAR CONSTRUCTION ACTIVITY, INCLUDING INSTALLATION, ERECTION, APPLICATION, AND SIMILAR OPERATIONS. INSTALLERS ARE REQUIRED TO BE EXPERIENCED IN THE OPERATIONS THEY ARE ENGAGED TO PERFORM.	
ELECTRONIC SYSTEMS: THE TERM "ELECTRONIC SYSTEMS" IS USED TO DESCRIBE ALL LOW VOLTAGE SYSTEMS GENERALLY REFERRED TO AS "SPECIAL SYSTEMS". THESE SYSTEMS INCLUDE BUT ARE NOT NECESSARILY LIMITED TO ALL SYSTEMS WHICH UTILIZE VOLTAGES OF LESS THAN 71 VOLTS SUCH AS SOUND SYSTEMS, VIDEO SYSTEMS, TV SYSTEMS, SECURITY SYSTEMS, VOICE AND DATA CABLING SYSTEMS, ETC...	

ABBREVIATIONS	
NOTE: ALL ABBREVIATIONS MAY NOT BE USED.	
1G	1–GANG ELECTRICAL BOX
2G	2–GANG ELECTRICAL BOX
3G	3–GANG ELECTRICAL BOX
4G	4–GANG ELECTRICAL BOX
4SQ	4–SQUARE ELECTRICAL BOX
ADA	AMERICANS WITH DISABILITIES ACT
ADJ	ADJACENT
C	CONDUIT
EMT	ELECTRICAL METALIC TUBING
EQUIP	EQUIPMENT
EXIST	EXISTING
LED	LIGHT EMITTING DIODE.
MAX	MAXIMUM
NA	NOT APPLICABLE
NC	NORMALLY CLOSED
NEC	NATIONAL ELECTRICAL CODE
NO	NORMALLY OPEN
NTS	NOT TO SCALE
QTY	QUANTITY
SPEC	SPECIFICATIONS
TVSS	TRANSIENT VOLTAGE SURGE SUPPRESSOR
TYP	TYPICAL
V	VOLTS
W/	WITH
W/O	WITHOUT

SYMBOL LEGEND	
SYMBOL	DESCRIPTION
	NURSE CALL MASTER CONSOLE.
	AREA CONTROL UNIT AND POWER SUPPLIES.
	PATIENT STATION WITH CALL CORD.
	DUTY STATION.
	COMBINATION EMERGENCY ASSIST/CODE BLUE STATION.
	STAFF REGISTRATION/CALL CANCEL STATION.
	BATH/TOILET/SHOWER STATION.
	HOUSE–KEEPING STATION.
	CODE BLUE ONLY STATION.
	STAFF INTERCOM STATION.
	CALL CORD RECEPTACLE WITH CALL CORD.
	MEDICAL EQUIPMENT ALARM INPUT RECEPTACLE (4 PORT).
	WIRELESS TELEPHONE BASE STATION.
	CORRIDOR/ZONE LIGHT.
	J–BOX/RECEPTACLE PLUG.
	SYSTEM CABLE – TYPICAL. SEE CABLE SCHEDULE.
	SERVER RACK.
	FIRE–TREATED PLYWOOD BACKBOARD.


SUBSCRIPT LEGEND	
SYMBOL	DESCRIPTION
C	COVER EXISTING DEVICE, PROVIDE SS BLANK COVER.
D	DEMO EXISTING DEVICE.
E	EXISTING DEVICE TO REMAIN.
N	NEW DEVICE, BOX, AND RACEWAY.
R	REMOVE AND REPLACE EXISTING DEVICE.

## VAMC SLC – NURSE CALL UPGRADE AS–BUILT DRAWINGS

Revisions																																																																																																																																																																																																																																																																																																																																																																																																																																																																																																																																																																																																																												
-----------	--	--	



File name: H:\CAD\660\_Asbuilt\Nurse Call Asbuilts 9-2-05\ACAD-71EY602.dwg Last Plotted: 05/22/2012 @ 10:20 By: vhas[crjan]

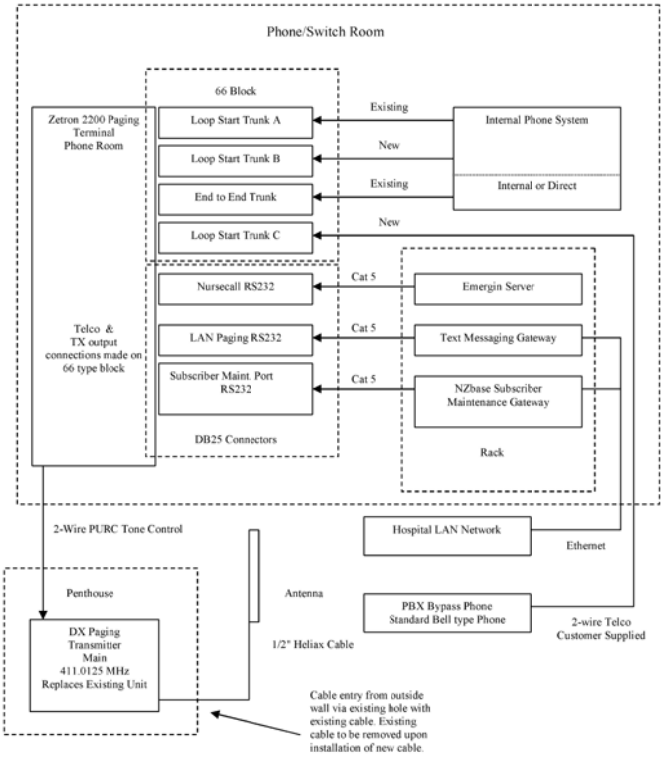


5 PAGING SYSTEM BLOCK DIAGRAM  
NTS


AC POWER REQUIREMENTS						
LOCATION	DESIGNATION	DESCRIPTION	AMPS	WATTS	UPS BACKUP TIME	CIRCUITS
TELEPHONE BOARD	ASCOM	RADIO EXCHANGE	2.5			
TELEPHONE BOARD	ASCOM	RADIO EXCHANGE	2.5			
TELEPHONE BOARD	ASCOM	RADIO EXCHANGE	2.5			
TELEPHONE BOARD	ASCOM	RADIO EXCHANGE	2.5			
TELEPHONE BOARD	ASCOM	SWITCHBOARD	2.5			
TELEPHONE BOARD	ZETRON	PAGING TERMINAL	2.5			
TOTAL			15.0	1800	11 MINUTES	5000VA, 1 EA 20 AMP
RACK	ASCOM	MOBILITY SERVER	3.5			
RACK	ASCOM	MOBILITY SERVER	3.5			
RACK	ASCOM	MOBILITY SERVER	3.5	1300	15 MINUTES	3000VA, 1 EA 20 AMP
RACK	POLYCOM	MGC-25 PAGE BRIDGE	2.0			
RACK	ADTRAN	ATLAS 550	3.0			
RACK	PC/SERVER 1		5.3			
RACK	PC/SERVER 2		5.3			
RACK	PC/SERVER 3		5.3			
RACK	PC/SERVER 4		5.3			
RACK	PC/SERVER 5		5.3			
RACK	CRT	MONITOR	2.5			
RACK	MISC	MODEMS, KVA	2.0			
TOTAL			35.8	4290	10 MINUTES	5000VA, 2 EA 20 AMP
TOTAL						4 EA 20 AMP

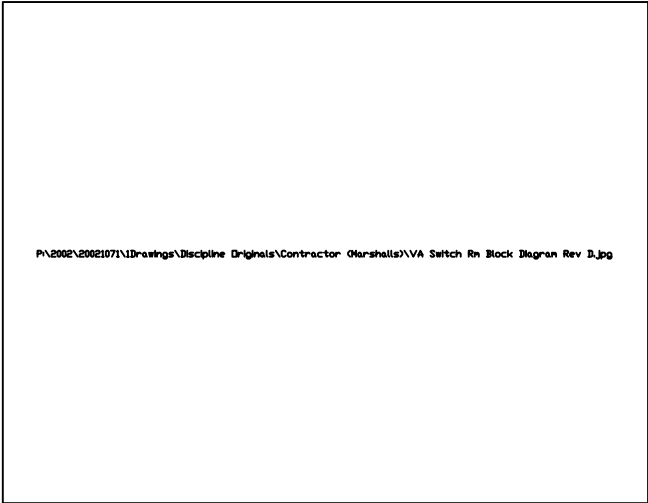


2 SWITCH ROOM EQUIPMENT BLOCK DIAGRAM  
NTS

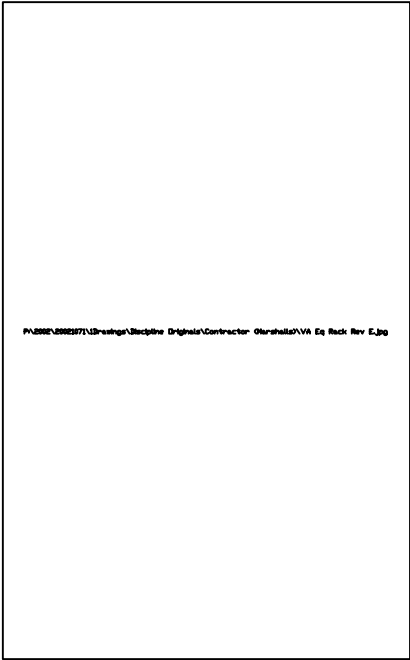

4 SERVER RACK ELEVATION DETAIL  
NTS

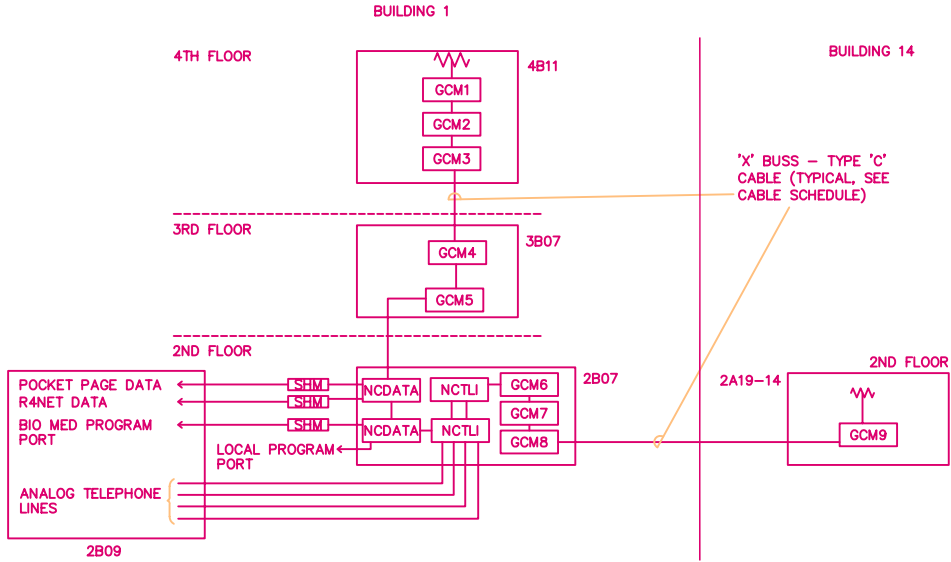

3 XBUSS RISER DIAGRAM  
NTS

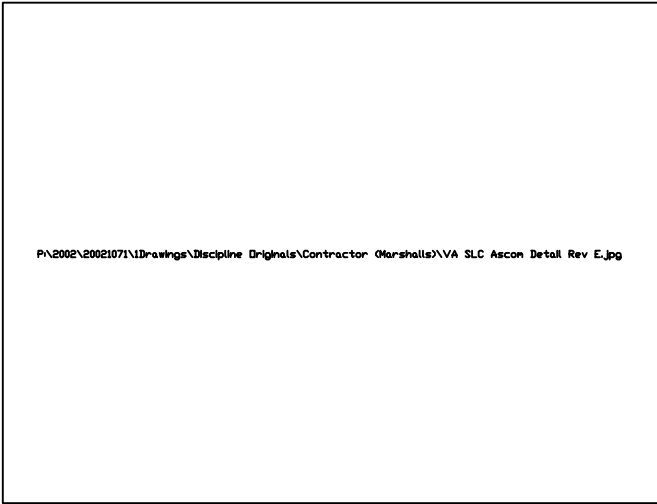

1 WIRELESS TELEPHONE EQUIPMENT BLOCK DIAGRAM  
NTS

Revisions			Drawing Title: NURSE CALL COMMUNICATIONS DETAILS	Project Title: NURSE CALL UPGRADE AS-BUILT DRAWINGS	Date: 03/18/05	Department of Veterans Affairs
			Approved:	Approved: Medical Center Director	Project No.:	
			Approved:	Approved: Chief, Engineering	Building Number:	
				Checked: RPN	Location: VAMC, SLC UTAH	
					DRAWING No. EY602	
					Dwg. OF	




## CABLE TYPE LEGEND

SYMBOL	DESCRIPTION (NON-PLENUM)	ACCEPTABLE TYPES
A	10 CONDUCTOR, 22 AWG, SHIELDED PAIR	WEST PENN 2010
B	4 PAIR, CAT 5 DATA CABLE	CATEGORY 5
C	4 PAIR, CAT 5 DATA CABLE	CATEGORY 5
D	FLAT, 6 CONDUCTOR	WEST PENN 37123
E	FLAT, 8 CONDUCTOR	WEST PENN 37127
F	20 AWG, SHIELDED PAIR	WEST PENN 292
G	2 CONDUCTOR, 22 AWG	WEST PENN 221
H	2 CONDUCTOR, 12 AWG	WEST PENN 227
I	2 CONDUCTOR, 16 AWG	WEST PENN 225
J	3 CONDUCTOR, 16 AWG	WEST PENN 235
K	2 CONDUCTOR, 18 AWG	WEST PENN 224
L	4 CONDUCTOR, 22 AWG	WEST PENN 241
M	2 PAIR, 22 AWG, SOLID	WEST PENN 251
N	8 CONDUCTOR, 22 AWG	WEST PENN 271
O	10 CONDUCTOR, 22 AWG	WEST PENN 272
P	RG-59, COAXIAL	WEST PENN 843
Q	RG-6, COAXIAL	WEST PENN 841
R	22 AWG, SHIELDED PAIR	WEST PENN 291
S	3 CONDUCTOR, 22 AWG, SHIELDED	WEST PENN 301
U	4 INDIVIDUAL SHIELDED PAIR, 22 AWG	WEST PENN 439
V	7 CONDUCTOR, 20 AWG	WEST PENN 263

## NURSE CALL DEVICES/FEATURES PER AREA TABLE


## NOTES

1. PROVIDE DEVICES AS INDICATED ON FLOOR PLANS AND PROVIDE CABLES AS REQUIRED PER MANUFACTURER'S WRITTEN INSTRUCTIONS. REFER TO SCHEDULE, AND 13750 FOR ADDITIONAL REQUIREMENTS.
2. COMPLETE AREA CONTROL UNIT ROOM--NUMBER PROGRAMMING WORK SHEET AND COORDINATE WITH HEAD OF STAFF IN EACH AREA BEFORE PROGRAMMING AREA CONTROL UNIT.
3. UTILIZE EXISTING CABLE TRAY AND EXISTING RACEWAYS WHERE POSSIBLE.
4. REFER TO CABLE TYPE SCHEDULE AND RUNS ON SHOP DRAWING FLOORPLANS.

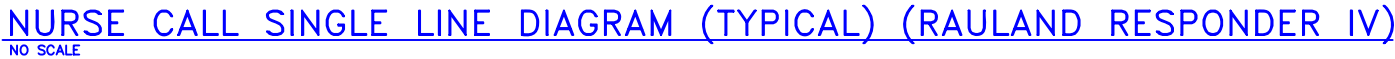


	Drawing Title		Project Title		Date
	NURSE CALL SYSTEM CABLE SCHEDULE AND DETAILS		NURSE CALL UPGRADE AS-BUILT DRAWINGS		03/18/0
Approved:	Approved: Medical Center Director		Drawn	Building Number	DRAWING No.
RUSSELL NAEGLER, E.I.T.			MEI		EY601
Approved:	Approved: Chief, Engineering		Checked	Location	Dwg. Of
			RPN	VAMC, SLC UTAH	




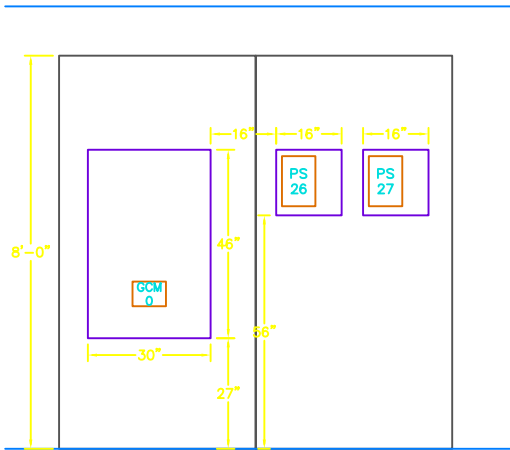


6 MICU RM 2A19  
EY401 WEST WALL ELEVATION  
NTS

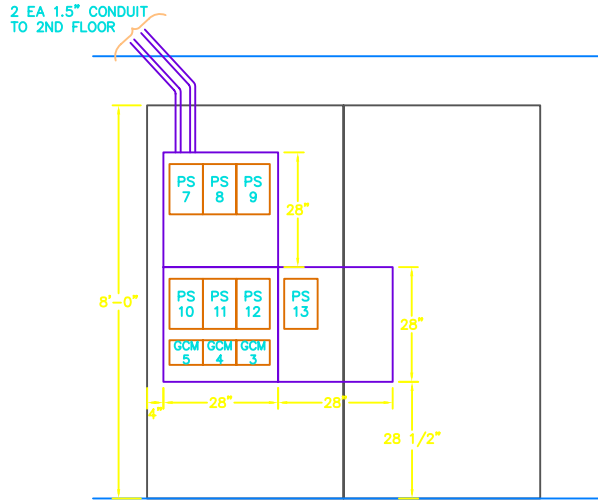


4 RM 3B07 NORTH WALL ELEVATION  
EY401 NTS

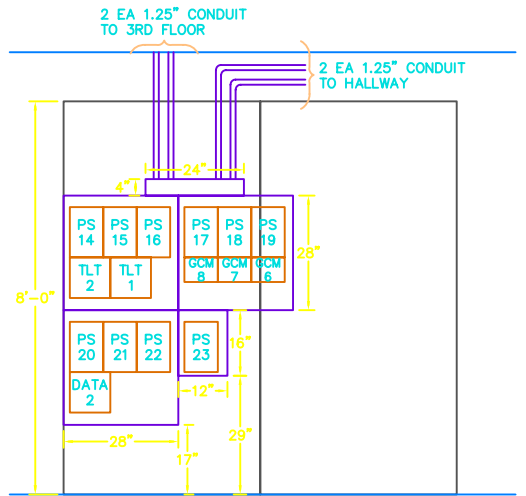


2 RM 2B07 SOUTH WALL ELEVATION  
EY401 NTS

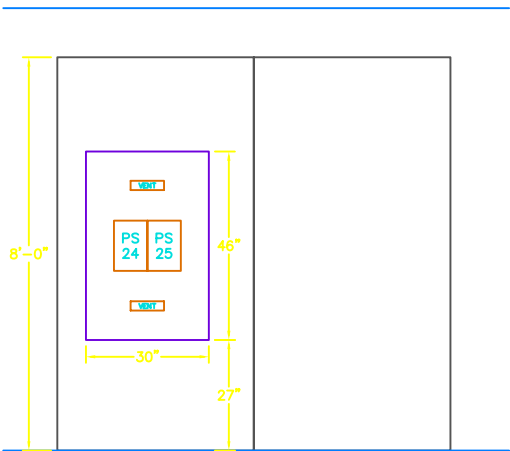

5 SICU RM 3A04A  
EY401 NORTH WALL ELEVATION  
NTS

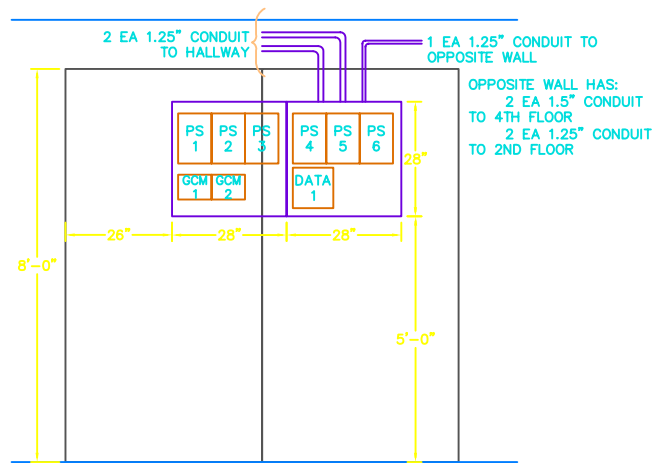

3 RM 4B11 NORTH WALL ELEVATION  
EY401 NTS

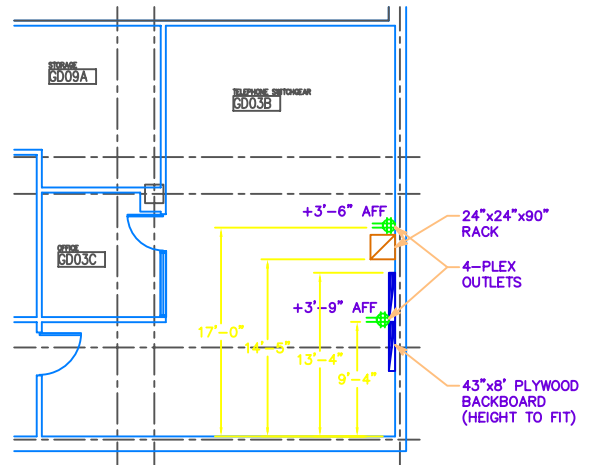

1 B1 - GROUND FLOOR MAIN  
EY401 TELE/DATA ROOM ENLARGED PLAN  
SCALE: 1/8"=1'-0"

Revisions	Date

--

CADD Information

Drawing Title:
COMMUNICATIONS ROOMS DETAILS
Approved: Approved: Chief, Engineering

Project Title
NURSE CALL UPGRADE AS-BUILT DRAWINGS
Approved: Medical Center Director
Building Number
Location VAMC, SLC UTAH


Date
03/18/08
Project No.
DRAWING No.
EY401
Dwg. Of

Department of  
Veterans Affairs








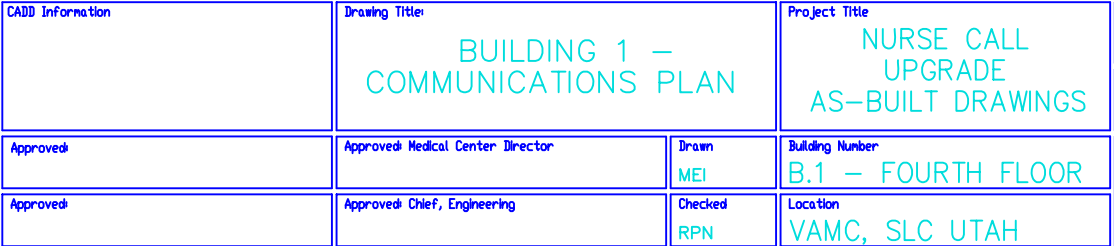



File name: H:\CAD\660 Asbuilts\Nurse Call Asbuilts 9-2-05\ACAD-71EY207.dwg Last Plotted: 05/22/2012 @ 10:14 By: vhascrayan]

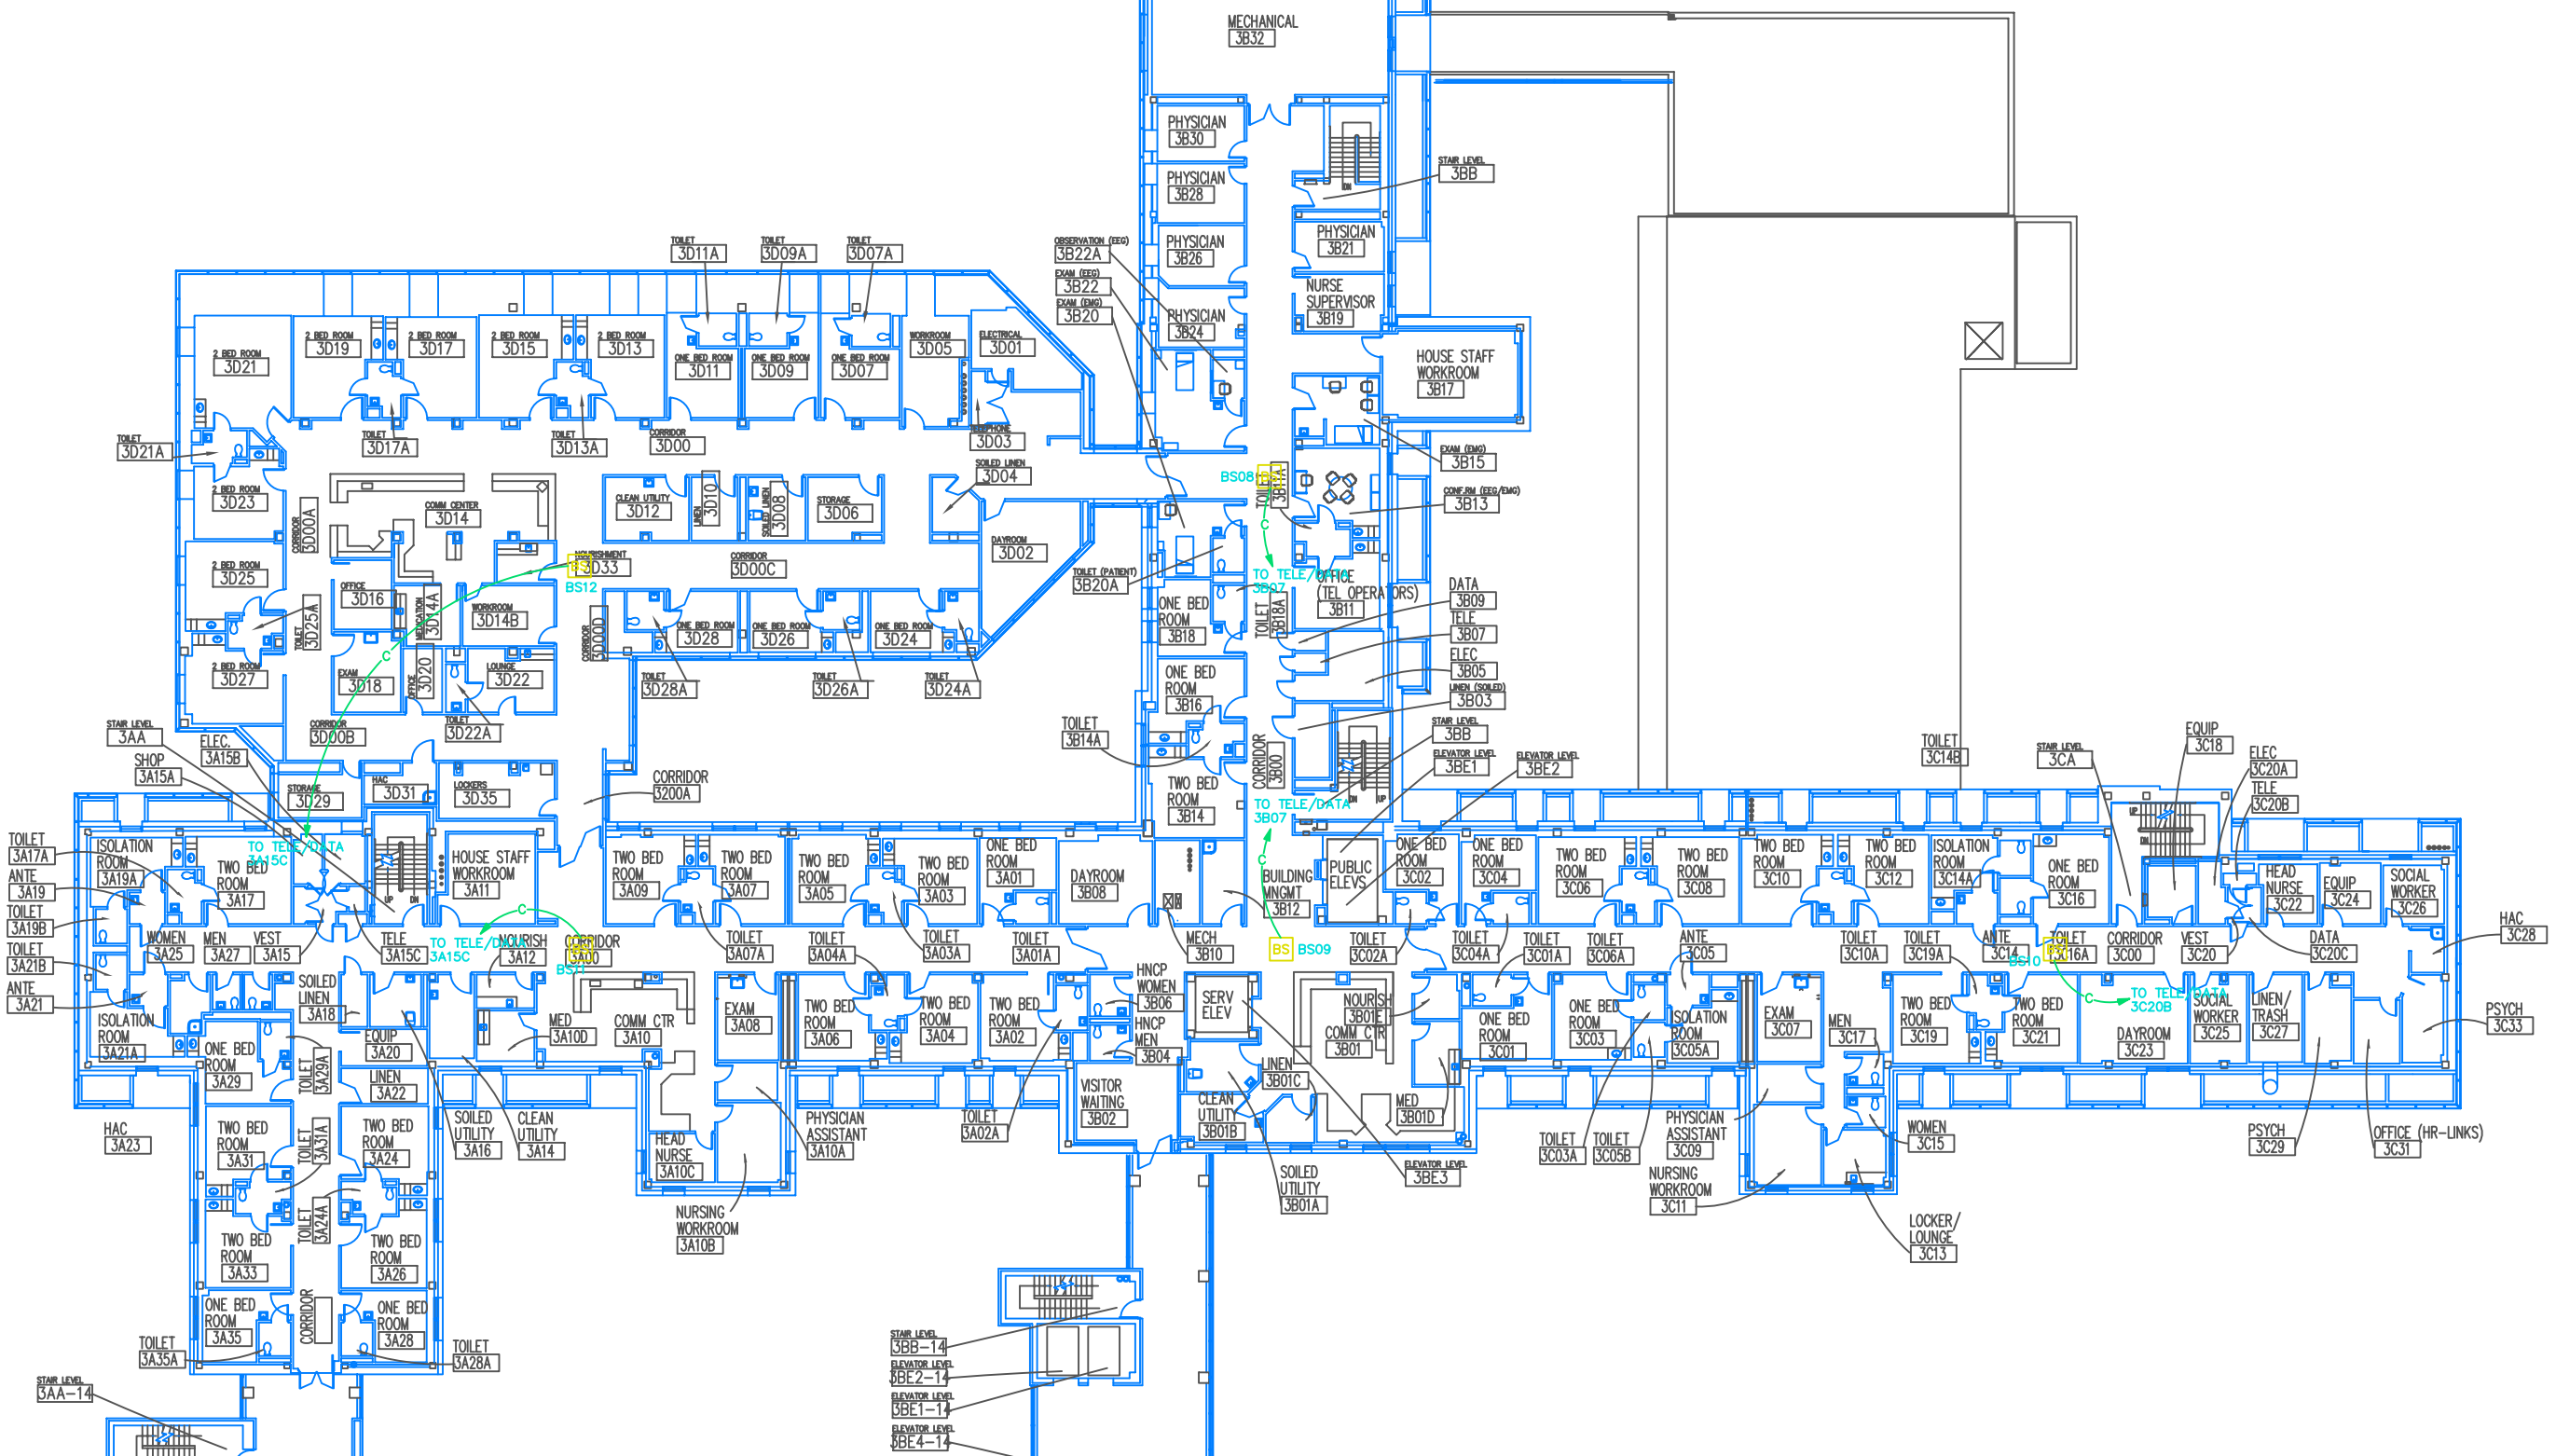


Revisions	CADD Information		Drawing Title:		Project Title		Date
			BUILDING 1 – COMMUNICATIONS PLAN		NURSE CALL UPGRADE AS-BUILT DRAWINGS		03/18/08
	Approved:		Approved: Medical Center Director		Building Number		Project No.
	Approved:		Approved: Chief, Engineering		B.1 – THIRD FLOOR		DRAWING No.
			Drawn	Checked	Location		Dwg. of
			MEI	RPN	VAMC, SLC UTAH		EY207

Department of Veterans Affairs







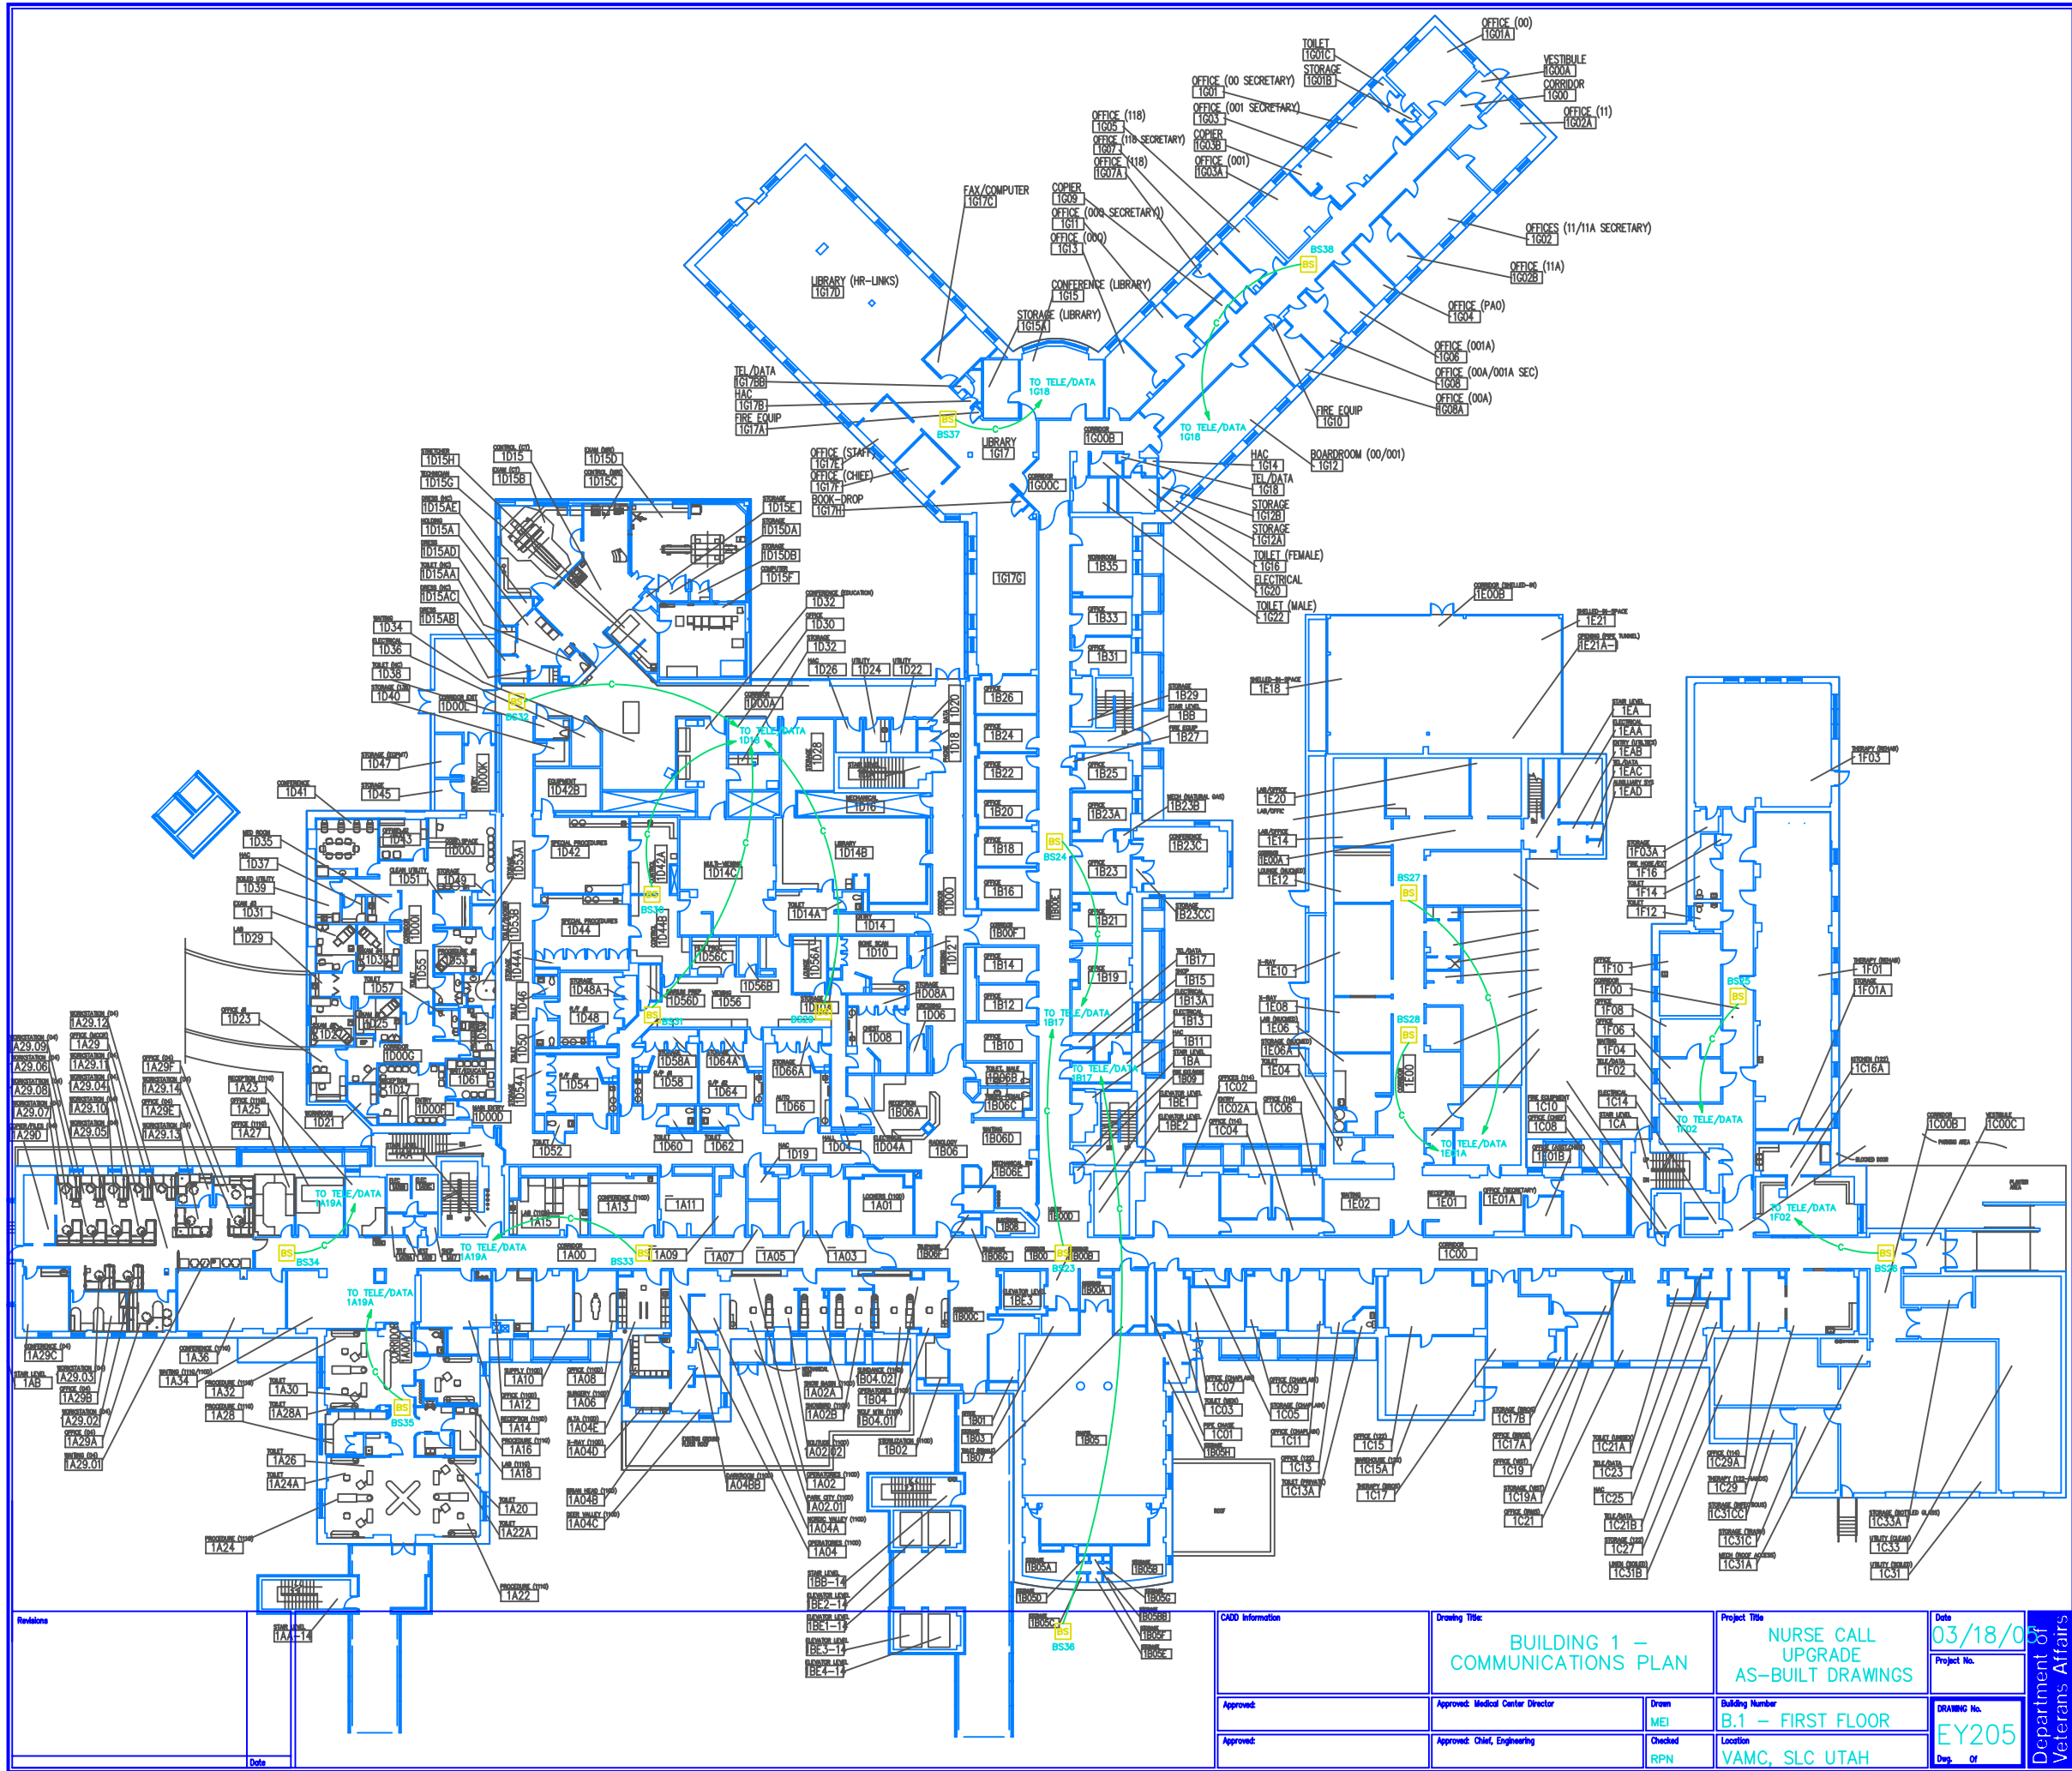

Revisions

Date

CADD Information

**BUILDING 1 -  
COMMUNICATIONS PLAN**

**NURSE CALL  
UPGRADE  
AS-BUILT DRAWINGS**

Date  
**03/18/08**

Project No.

Approved:

Approved: Medical Center Director

Drawn

MEI

Building Number

**B.1 - FIRST FLOOR**

DRAWING No.  
**EY205**

Approved:

Approved: Chief, Engineering

Checked

RPN


Location

**VAMC, SLC UTAH**

Dep. Of


Department of  
Veterans Affairs



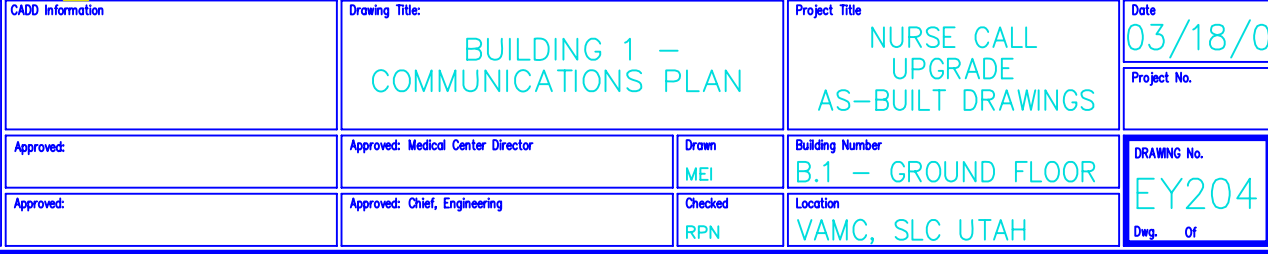



File name: H:\CAD\660 Asbuilts\Nurse Call Asbuilts 9-2-05\ACAD-71EY203.dwg Last Plotted: 05/22/2012 @ 10:10 By: vhasicryanj

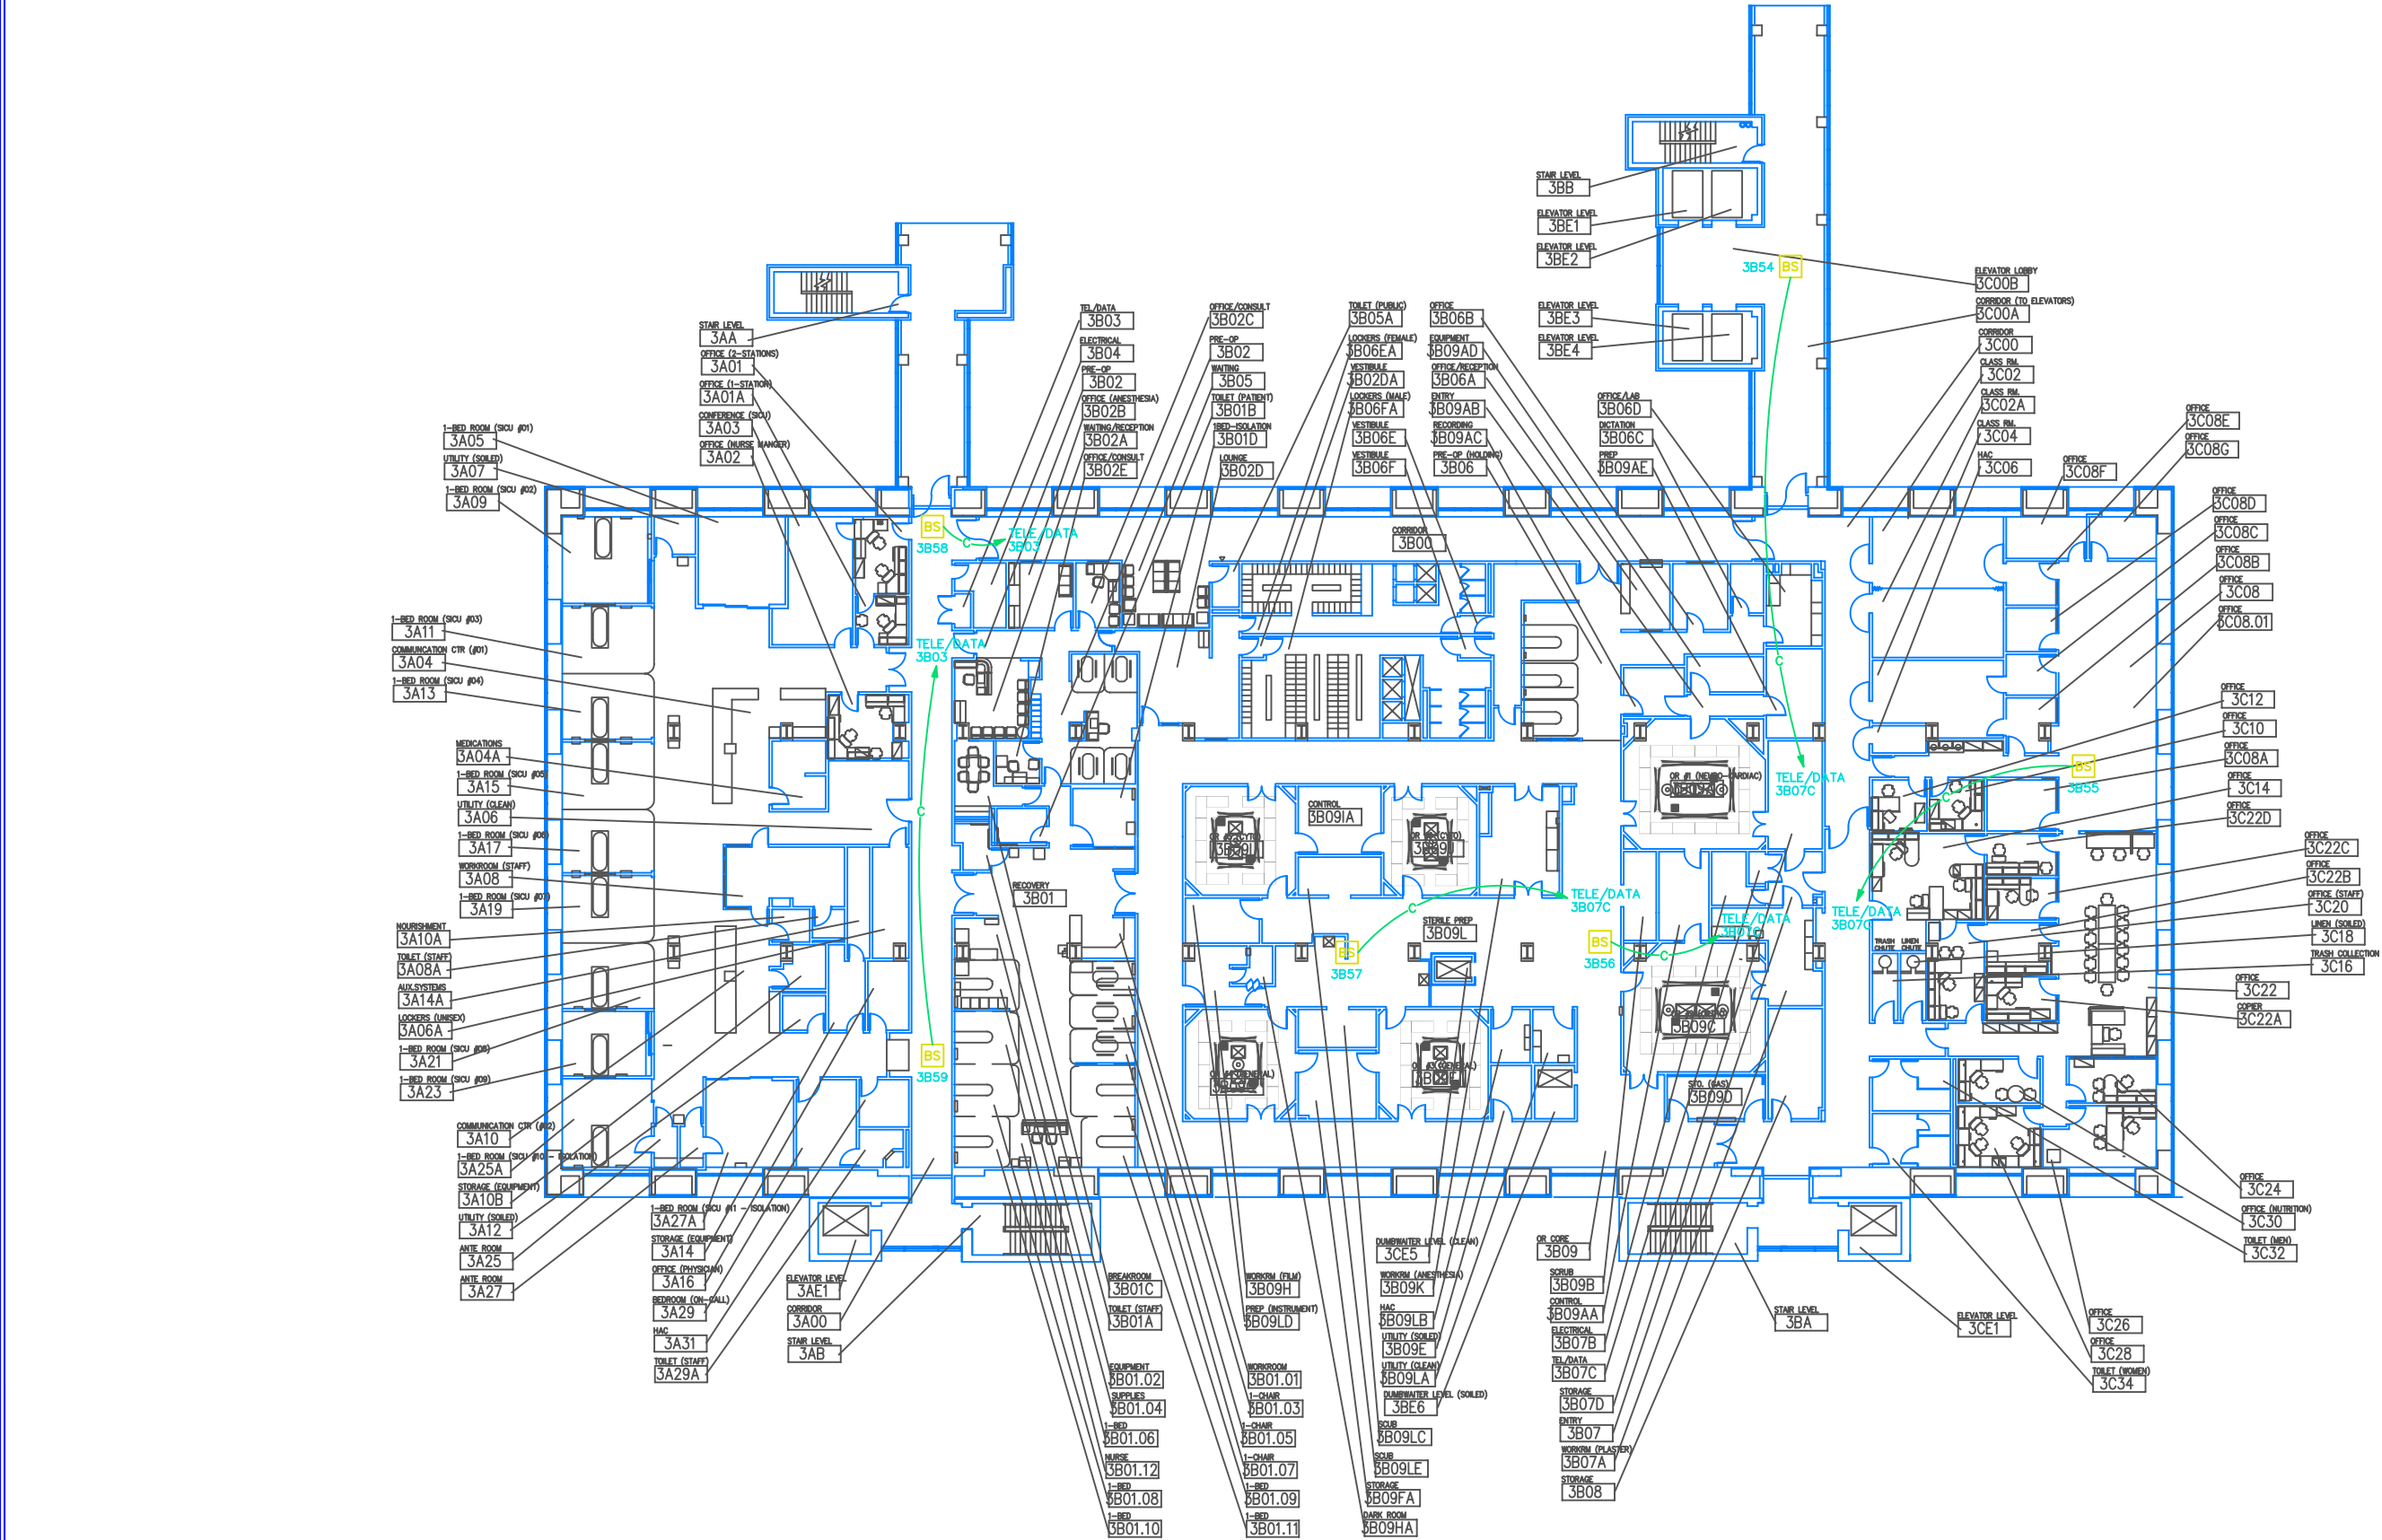

Revisions	CADD Information		Drawing Title		Project Title		Date
	SCALE: 1/16		BUILDING 14 – COMMUNICATIONS PLAN		NURSE CALL UPGRADE AS-BUILT DRAWINGS		03/18/05
	Approved		Approved Medical Center Director		Drawn		Project No.
	Approved		Approved Chief, Engineering		MEI		
Date	Approved		Checked		RPN		DRAWING No.
			Location		VAMC, SLC UTAH		EY203
							Dwg. Of





Date	03/18/0
Project No.	
DRAWING No.	EY202
Dwg.	Of



**Department of  
Veterans Affairs**



File name: H:\CAD\660 Asbuilts\Nurse Call Asbuilts 9-2-05\ACAD-71EY119.dwg Last Plotted: 05/22/2012 @ 10:08 By: vhasicryanj


SHEET KEYNOTES

1. PROVIDE STAINLESS STEEL STAFF STATION AT INDICATED LOCATION.

GENERAL SHEET NOTES

1. ADD DEVICES TO RESPONDER III PLUS NURSE CALL SYSTEM AS INDICATED. PROVIDE NEW BOXES, RACEWAYS, AND CABLES AS REQUIRED. UTILIZE EXISTING CABLE TRAYS.

2. PROVIDE WIRELESS PHONE COVERAGE THROUGHOUT AREA INCLUDING SUPPORT OFFICES.

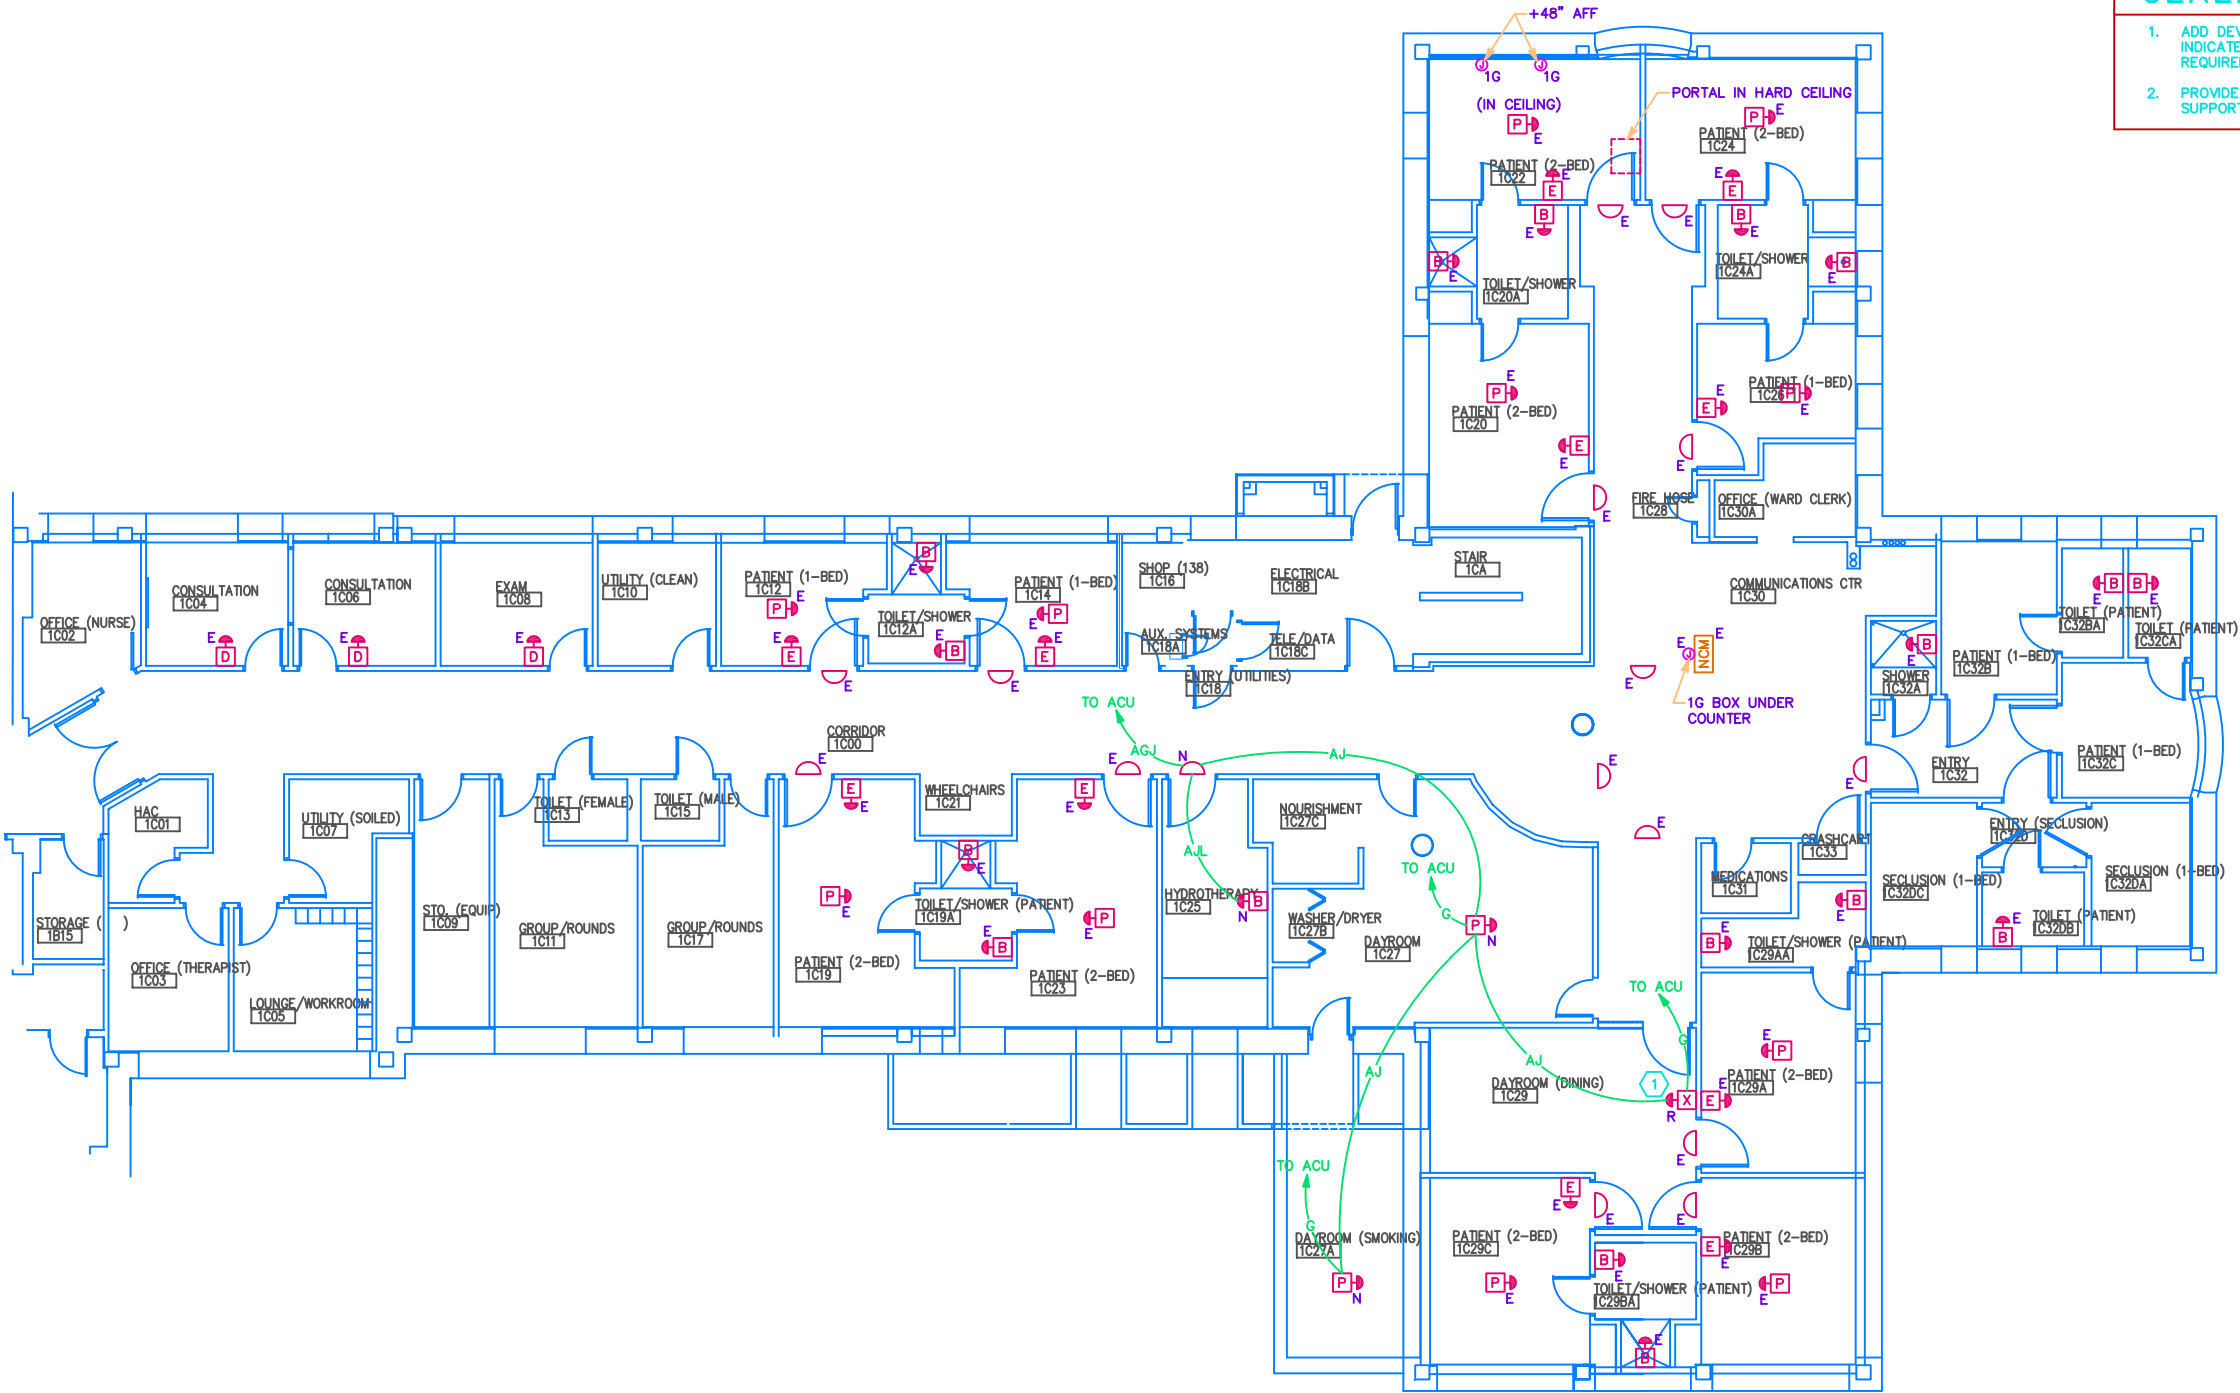


WARD 3A AREA – PHASE I NURSE CALL PLAN  
SCALE: 1/8"=1'-0"

Revisions			CADD Information	Drawing Title <div>WARD 3A AREA</div>		Project Title <div>NURSE CALL UPGRADE AS-BUILT DRAWINGS</div>		Date <div>03/18/08</div>	Department of Veterans Affairs
								Project No.	
				Approved	Approved Medical Center Director	Drawn MEI	Building Number B.3 – FIRST FLOOR	DRAWING No. EY119	
Approved	Approved Chief, Engineering	Checked RPN	Location VAMC, SLC UTAH	Dwg. Of					
	Date								



1. PROVIDE NCM RECEPTACLE PLUG FOR FUTURE USE.

1. REPLACE EXISTING FISHER-BERKLEY NURSE CALL DEVICES AND PROVIDE NEW DEVICES AS INDICATED. PROVIDE NEW BOXES, RACEWAYS, AND CABLES AS REQUIRED. UTILIZE EXISTING CABLE TRAYS.

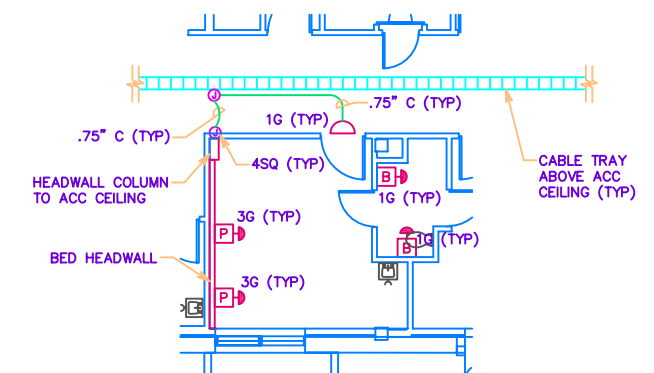

SCALE: 1/8"=1'-0"

EY118 SCALE: 1/8"=1'-0"

Department of  
Veterans Affairs



1. PROVIDE NCM RECEPTACLE PLUG FOR FUTURE USE.
2. CABLE-TIE EXISTING CALL CORD TAG TO NEW CALL CORD.




1 PATIENT ROOM RACEWAY DETAIL – TYPICAL  
EY117 SCALE: 1/8"=1'-0"

Department of  
Veterans Affairs



1. REPLACE EXISTING FISHER-BERKLEY NURSE CALL DEVICES AND PROVIDE NEW DEVICES AS INDICATED. PROVIDE NEW BOXES, RACEWAYS, AND CABLES AS REQUIRED. UTILIZE EXISTING CABLE TRAYS.

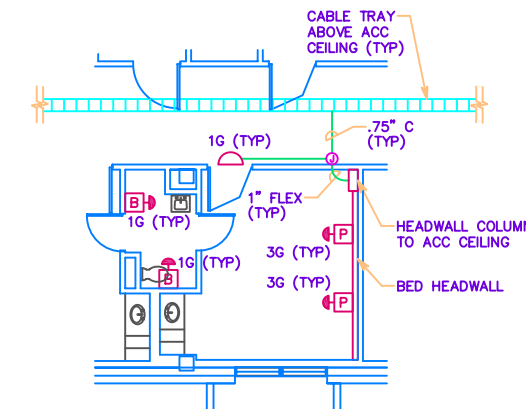



1 PATIENT ROOM RACEWAY DETAIL – TYPICAL  
EY115 SCALE: 1/8"=1'-0"

### Can #3: Power Supply 13

SCALE: 1/8"=1'-0"

Department of  
Veterans Affairs



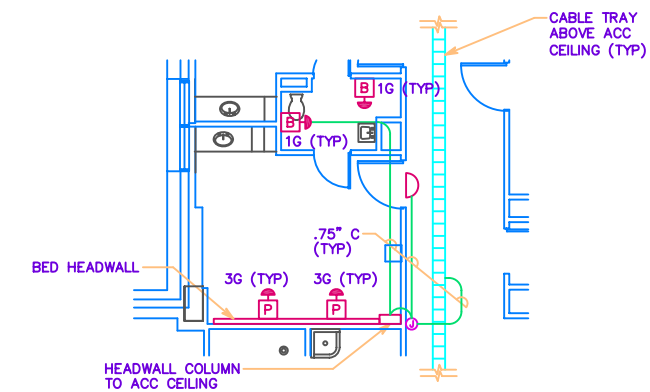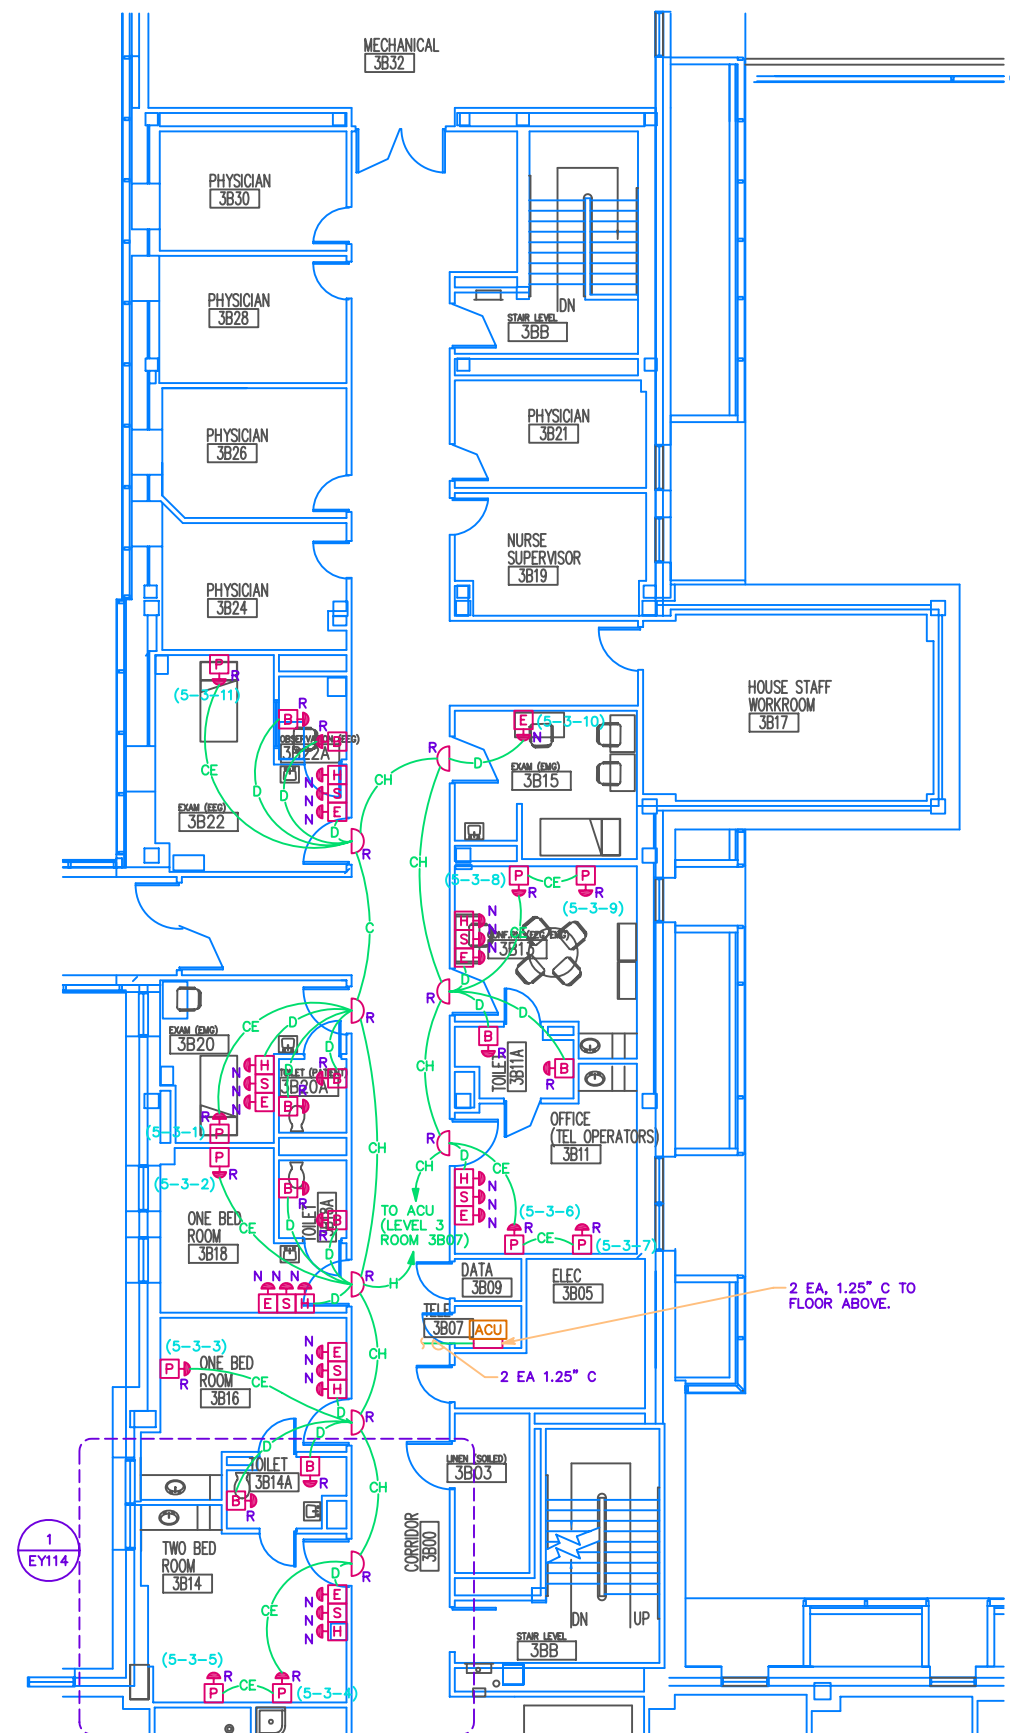

1 PATIENT ROOM RACEWAY DETAIL – TYPICAL  
EY114 SCALE: 1/8"=1'-0"


### Can #3: Power Supply 13

**SURGERY CLINICS (3E) – PHASE I NURSE CALL PLAN**  
SCALE: 1/8"=1'-0"

Revisions			CADD Information	Drawing Title SURGERY CLINICS (3E)	Project Title NURSE CALL UPGRADE AS-BUILT DRAWINGS	Date 03/18/05
			Approved	Approved Medical Center Director	Drawn MEI	Project No.
			Approved	Approved Chief, Engineering	Checked RPN	DRAWING No. EY114
	Date				Building Number B.1 - THIRD FLOOR	Dwg. Of
					VAMC, SLC UTAH	



1. REPLACE EXISTING FISHER-BERKLEY NURSE CALL DEVICES AND PROVIDE NEW DEVICES AS INDICATED. PROVIDE NEW BOXES, RACEWAYS, AND CABLES AS REQUIRED. UTILIZE EXISTING CABLE TRAYS.

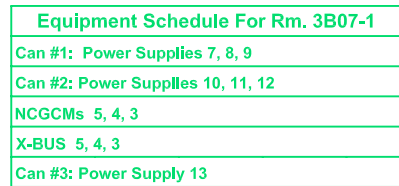

## SURGERY CLINICS (3W) – PHASE I NURSE CALL PLAN

Revisions																																																																																																																																																																																																																																																																																																																																																																																																																																																																																																																																																																																																								
-----------	--	--	


1. PROVIDE 3G TO 1G ADAPTER PLATE FOR EXISTING 3G BOX.

1. REPLACE EXISTING FISHER-BERKLEY NURSE CALL DEVICES AND PROVIDE NEW DEVICES AS INDICATED. PROVIDE NEW BOXES, RACEWAYS, AND CABLES AS REQUIRED. UTILIZE EXISTING CABLE TRAYS.

The floor plan for Level 2, Room 2B07, is a complex layout of patient rooms and support spaces. Key areas include:



- Public Elevators (2BE1, 2BE2):** Located on the left side of the plan.
- Corridor 2C00:** A central corridor connecting various rooms.
- Room 2C07 (Exam):** A room for medical examinations.
- Room 2C09 (Office PA):** An office for the Patient Association.
- Room 2C11 (Workroom Staff):** A workroom for staff.
- Room 2C13 (Office MD Nurse):** An office for the Medical Director and Nurse.
- Room 2C15 (Toilet Male/Female):** Restrooms for male and female patients.
- Room 2C17 (Office (Nurse)):** An office for a nurse.
- Room 2C19 (2-Bed Room):** A room with two beds.
- Room 2C21 (2-Bed Room):** Another room with two beds.
- Room 2C23 (Dayroom):** A room for patients to relax.
- Room 2C25 (Office (Physician)):** An office for a physician.
- Room 2C27 (Linen Chute (Soiled)):** A chute for soiled linens.
- Room 2C29 (Offices (Heart Transplant)):** Offices for heart transplant patients.
- Room 2C31 (Office (Physician)):** Another office for a physician.
- Room 2C33 (Office (Chief)):** An office for the Chief of Staff.
- Room 2C35 (Office (Physician)):** Another office for a physician.
- Room 2C37 (Office (Physician)):** Another office for a physician.
- Room 2C39 (Office (Physician)):** Another office for a physician.
- Room 2C99 (Office (Physician)):** Another office for a physician.
- Room 2C01 (1-Bed Room):** A room with one bed.
- Room 2C03 (1-Bed Room):** Another room with one bed.
- Room 2C05 (1-Bed Room):** Another room with one bed.
- Room 2C07 (Exam):** A room for medical examinations.
- Room 2C09 (Office PA):** An office for the Patient Association.
- Room 2C11 (Workroom Staff):** A workroom for staff.
- Room 2C13 (Office MD Nurse):** An office for the Medical Director and Nurse.
- Room 2C15 (Toilet Male/Female):** Restrooms for male and female patients.
- Room 2C17 (Office (Nurse)):** An office for a nurse.
- Room 2C19 (2-Bed Room):** A room with two beds.
- Room 2C21 (2-Bed Room):** Another room with two beds.
- Room 2C23 (Dayroom):** A room for patients to relax.
- Room 2C25 (Office (Physician)):** An office for a physician.
- Room 2C27 (Linen Chute (Soiled)):** A chute for soiled linens.
- Room 2C29 (Offices (Heart Transplant)):** Offices for heart transplant patients.
- Room 2C31 (Office (Physician)):** Another office for a physician.
- Room 2C33 (Office (Chief)):** An office for the Chief of Staff.
- Room 2C35 (Office (Physician)):** Another office for a physician.
- Room 2C37 (Office (Physician)):** Another office for a physician.
- Room 2C39 (Office (Physician)):** Another office for a physician.
- Room 2C99 (Office (Physician)):** Another office for a physician.
- Room 2C02 (2-Bed Room):** A room with two beds.
- Room 2C04 (2-Bed Room):** Another room with two beds.
- Room 2C06 (1-Bed Room):** A room with one bed.
- Room 2C08 (Lounge/Loops):** A lounge area for patients.
- Room 2C10 (Toilet (Patient)):** A toilet for patients.
- Room 2C12 (Office (Yellow)):** An office for yellow fever patients.
- Room 2C14 (1-Bed Isolation):** A room for isolation of one patient.
- Room 2C16 (1-Bed Room):** A room with one bed.
- Room 2C18 (Stair 2CA):** A staircase.
- Room 2C20 (Electrical 2C20A):** An electrical room.
- Room 2C22 (Tel/Data 2C20B):** A room for telecommunications and data.
- Room 2C24 (Ally System 2C20C):** A room for an ally system.
- Room 2C26 (Entry Utilities 2C20D):** A room for entry utilities.
- Room 2C28 (Stair 2CB):** A staircase.
- Room 2C30 (Office (Physician)):** An office for a physician.
- Room 2C32 (Office (Physician)):** Another office for a physician.
- Room 2C34 (Office (Physician)):** Another office for a physician.
- Room 2C36 (Office (Physician)):** Another office for a physician.
- Room 2C38 (Office (Physician)):** Another office for a physician.
- Room 2C40 (Office (Physician)):** Another office for a physician.
- Room 2C42 (Office (Physician)):** Another office for a physician.
- Room 2C44 (Office (Physician)):** Another office for a physician.
- Room 2C46 (Office (Physician)):** Another office for a physician.
- Room 2C48 (Office (Physician)):** Another office for a physician.
- Room 2C50 (Office (Physician)):** Another office for a physician.
- Room 2C76 (Office (Physician)):** Another office for a physician.
- Room 2C78 (Office (Physician)):** Another office for a physician.
- Room 2C80 (Office (Physician)):** Another office for a physician.
- Room 2C82 (Office (Physician)):** Another office for a physician.
- Room 2C84 (Office (Physician)):** Another office for a physician.
- Room**

## ACUTE MED AREA (2E) – PHASE I NURSE CALL PLAN

**Department of  
Veterans Affairs**



Equipment Schedule For Rm. 2B07-1			
Can #1:	Power Supplies 13, 14, 15		
	NCTLIs 1, 2		
	X-BUS 12, 13		
Can #2:	Power Supplies 17, 18, 19		
	NCGMs 8, 7, 6		
	X-BUS 8, 7, 6		
Can #3:	Power Supplies 20, 21, 22		
	NCDATA 2		
	X-BUS 11		
Can #4:	Power Supply 23		
	Battery Back-up		

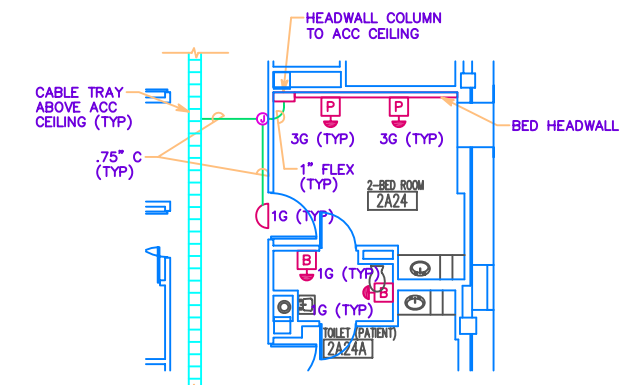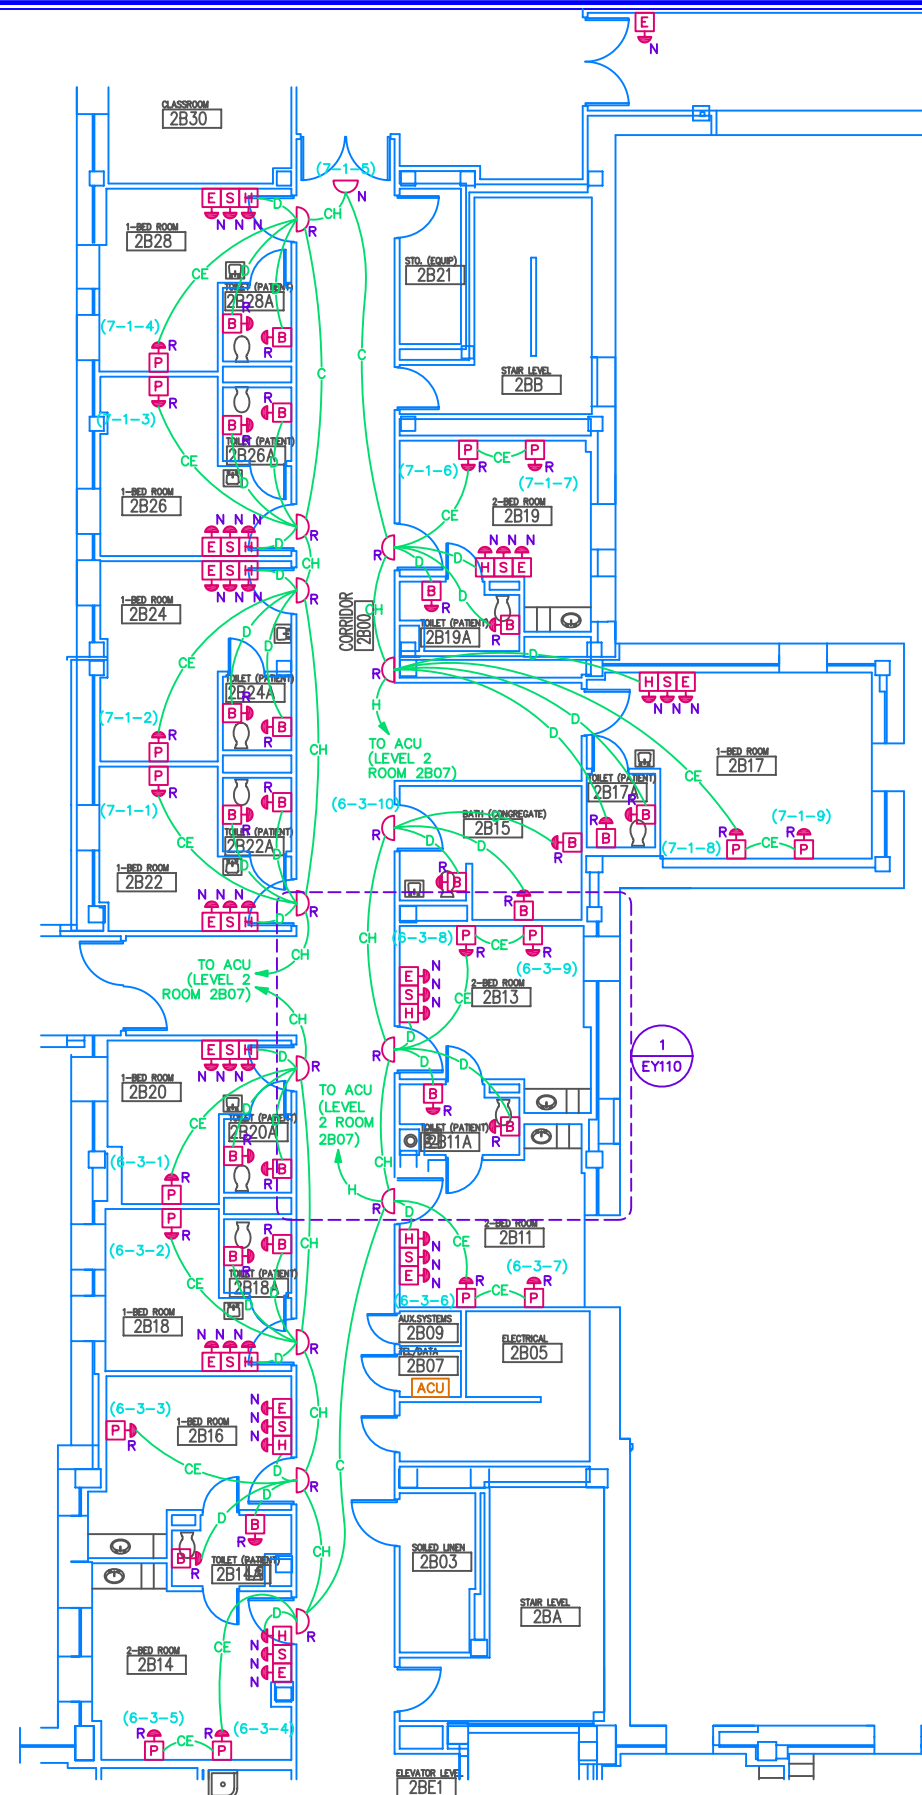

1 PATIENT ROOM RACEWAY DETAIL – TYPICAL  
EY110 SCALE: 1/8"=1'-0"

ACUTE MED AREA (2E) – PHASE I NURSE CALL PLAN

Revisions			CADD Information	Drawing Title ACUTE MED AREA (2E)		Project Title NURSE CALL UPGRADE AS-BUILT DRAWINGS		Date 03/18/05
			Approved	Approved Medical Center Director	Drawn MEI	Building Number B.1 – SECOND FLOOR		Project No.
			Approved	Approved Chief, Engineering	Checked RPN	Location VAMC, SLC UTAH		DRAWING No. EY110
	Date							Dwg. Of

Department of  
Veterans Affairs




SHEET KEYNOTES


- 1. PROVIDE 2ND MASTER STATION RECEPTACLE AT INDICATED LOCATION.
- 2. PROVIDE 3G TO 1G ADAPTER PLATE FOR EXISTING 3G BOX.

GENERAL SHEET NOTES

- 1. REPLACE EXISTING FISHER-BERKLEY NURSE CALL DEVICES AND PROVIDE NEW DEVICES AS INDICATED. PROVIDE NEW BOXES, RACEWAYS, AND CABLES AS REQUIRED. UTILIZE EXISTING CABLE TRAYS.

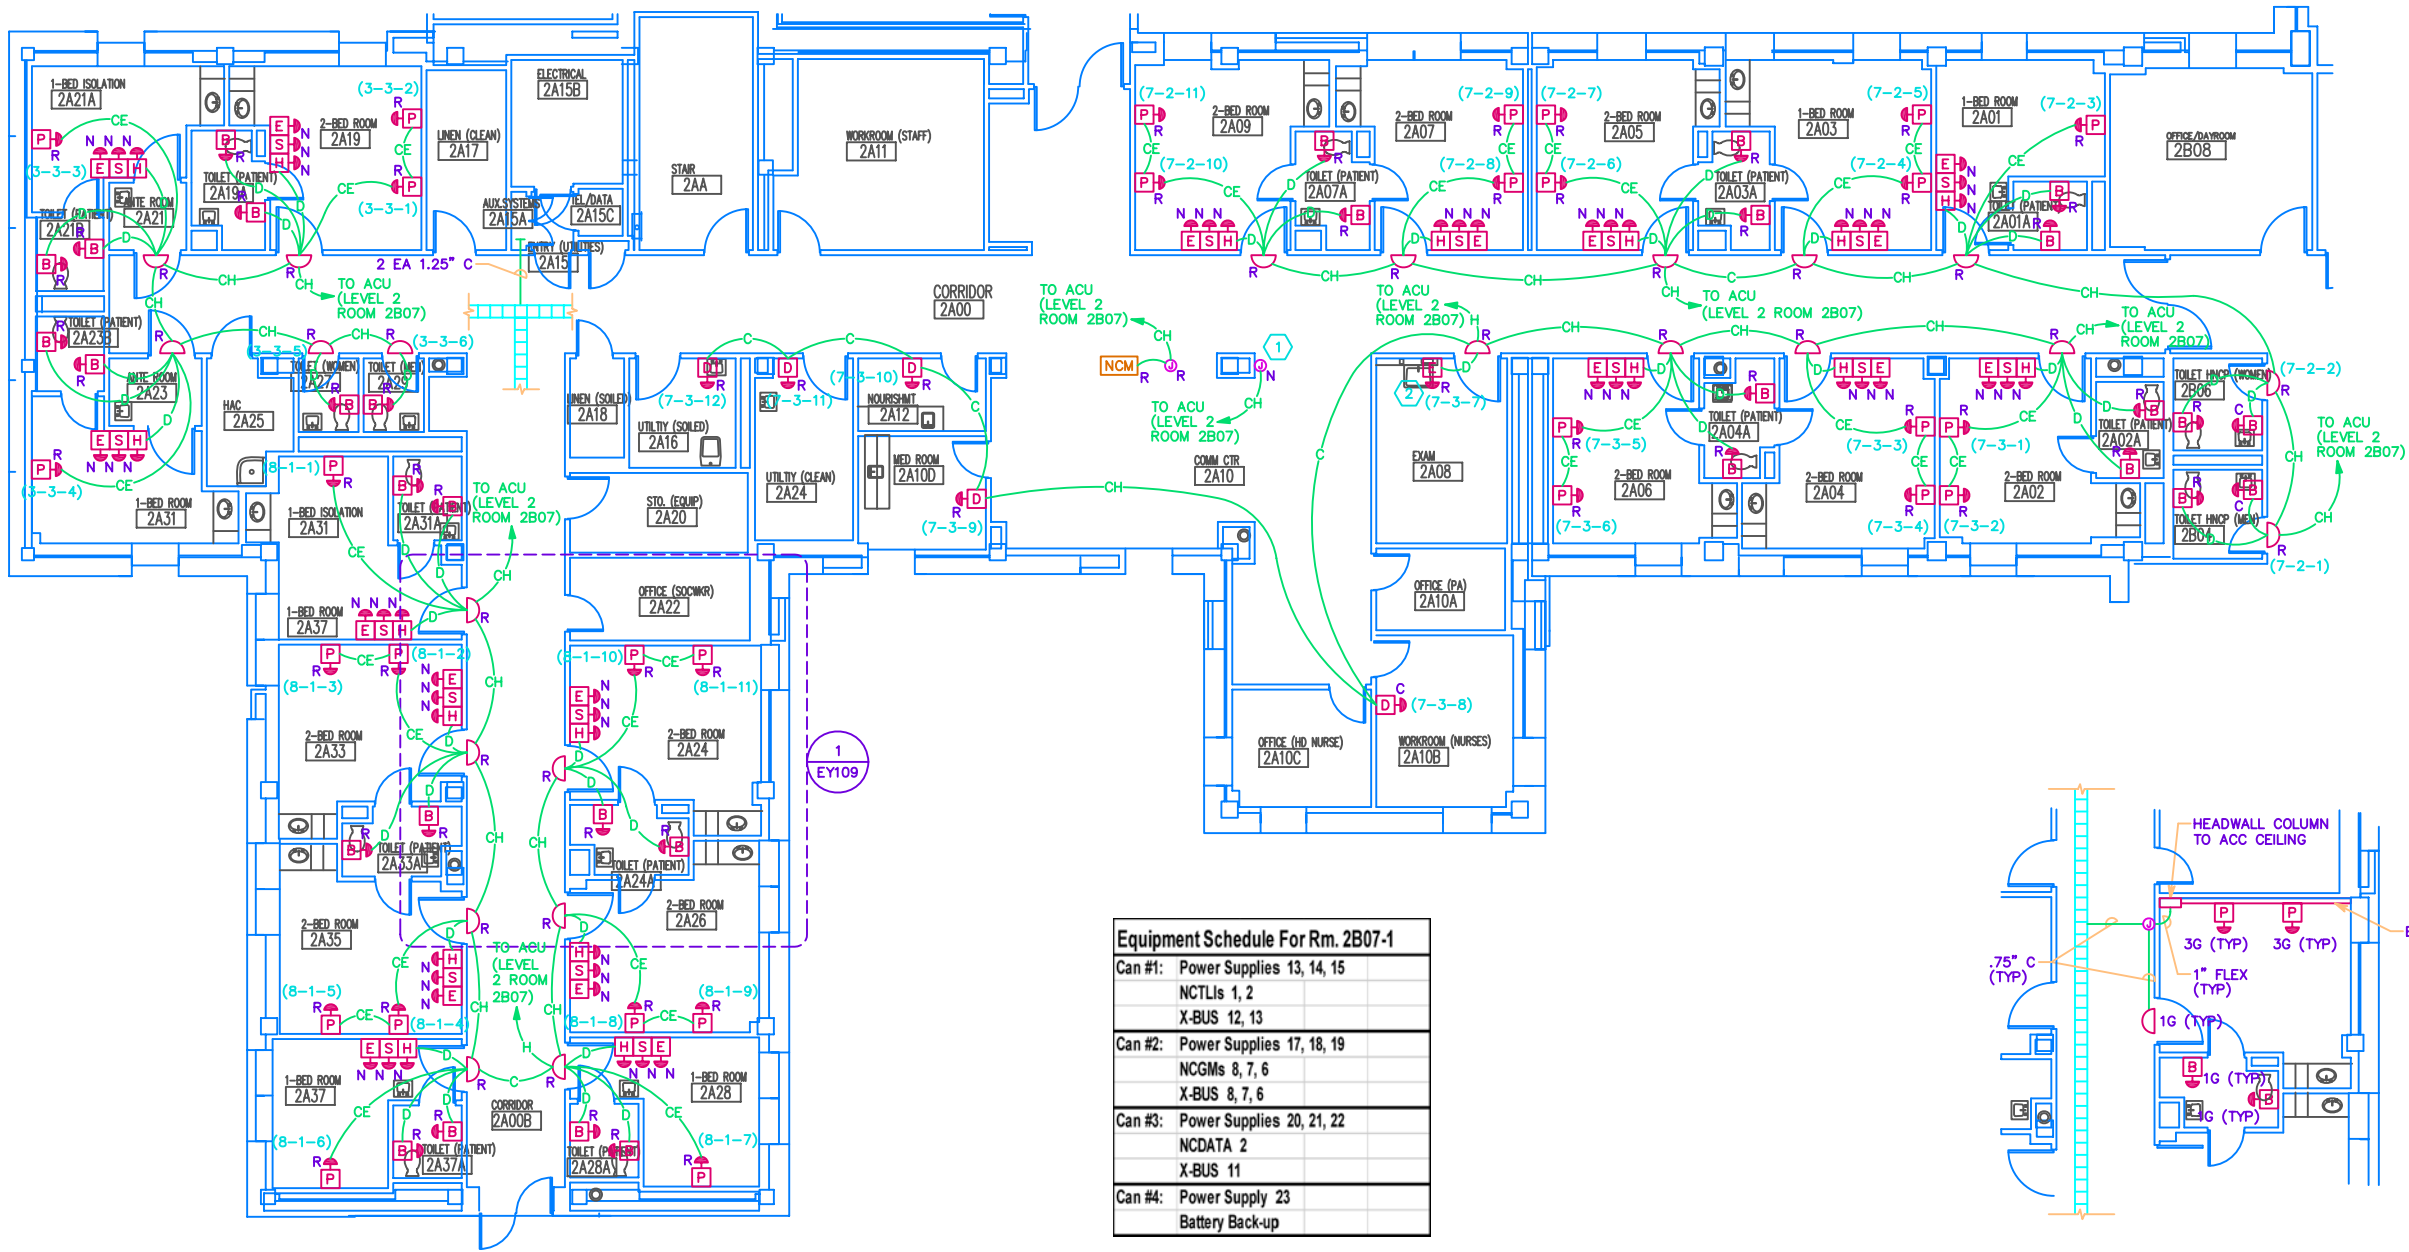

Equipment Schedule For Rm. 2B07-1			
Can #1:	Power Supplies 13, 14, 15		
	NCTLIs 1, 2		
	X-BUS 12, 13		
Can #2:	Power Supplies 17, 18, 19		
	NCGMs 8, 7, 6		
	X-BUS 8, 7, 6		
Can #3:	Power Supplies 20, 21, 22		
	NCDATA 2		
	X-BUS 11		
Can #4:	Power Supply 23		
	Battery Back-up		

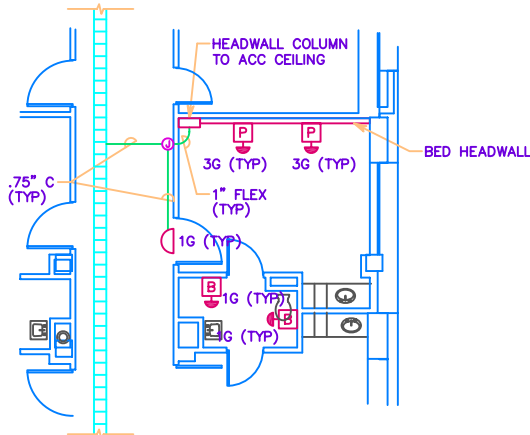

1 PATIENT ROOM RACEWAY DETAIL – TYPICAL  
EY109 SCALE: 1/8"=1'-0"

ACUTE MED AREA (2W) – PHASE I NURSE CALL PLAN  
SCALE: 1/8"=1'-0"

File name: H:\CAD\660 Asbuilts\Nurse Call Asbuilts 9-2-05\ACAD-71EY109.dwg Last Plotted: 05/22/2012 @ 10:00 By: vhasicryanj

Revisions		CADD Information		Drawing Title		Project Title		Date
				ACUTE MED AREA (2W)		NURSE CALL UPGRADE AS-BUILT DRAWINGS		03/18/08
		Approved		Approved Medical Center Director		Drawn MEI		Project No.
		Approved		Approved Chief, Engineering		Checked RPN		DRAWING No. EY109
						Building Number B.1 – SECOND FLOOR		Dwg. Of
						Location VAMC, SLC UTAH		

Department of Veterans Affairs




GENERAL SHEET NOTES

1. REPLACE EXISTING FISHER-BERKLEY NURSE CALL DEVICES AND PROVIDE NEW DEVICES AS INDICATED. PROVIDE NEW BOXES, RACEWAYS, AND CABLES AS REQUIRED. UTILIZE EXISTING CABLE TRAYS.

Equipment Schedule For Rm. 2B07-1

Can #1:	Power Supplies 13, 14, 15
	NCTLIs 1, 2
	X-BUS 12, 13
Can #2:	Power Supplies 17, 18, 19
	NCGMs 8, 7, 6
	X-BUS 8, 7, 6
Can #3:	Power Supplies 20, 21, 22
	NCDATA 2
	X-BUS 11
Can #4:	Power Supply 23
	Battery Back-up

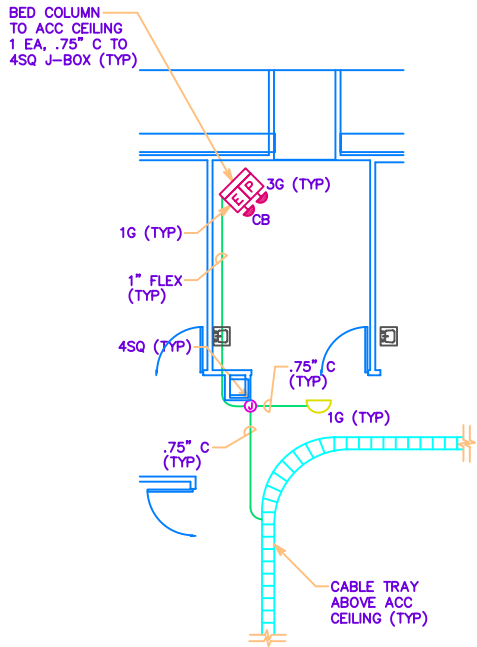


1 PATIENT ROOM RACEWAY DETAIL – TYPICAL  
EY108 SCALE: 1/8"=1'-0"

TELEMETRY/CCU AREA – PHASE I NURSE CALL PLAN  
SCALE: 1/8"=1'-0"

Revisions			CADD Information			Drawing Title:  TELEMETRY/ CCU AREA		Project Title:  NURSE CALL UPGRADE AS-BUILT DRAWINGS		Date: 03/18/08
										Project No.:
			Approved:			Approved: Medical Center Director		Drawn: MEI	Building Number: B.1 – SECOND FLOOR	
	Approved:			Approved: Chief, Engineering		Checked: RPN	Location: VAMC, SLC UTAH		EY108 Dwg. Of:	
	Date:									

Department of  
Veterans Affairs



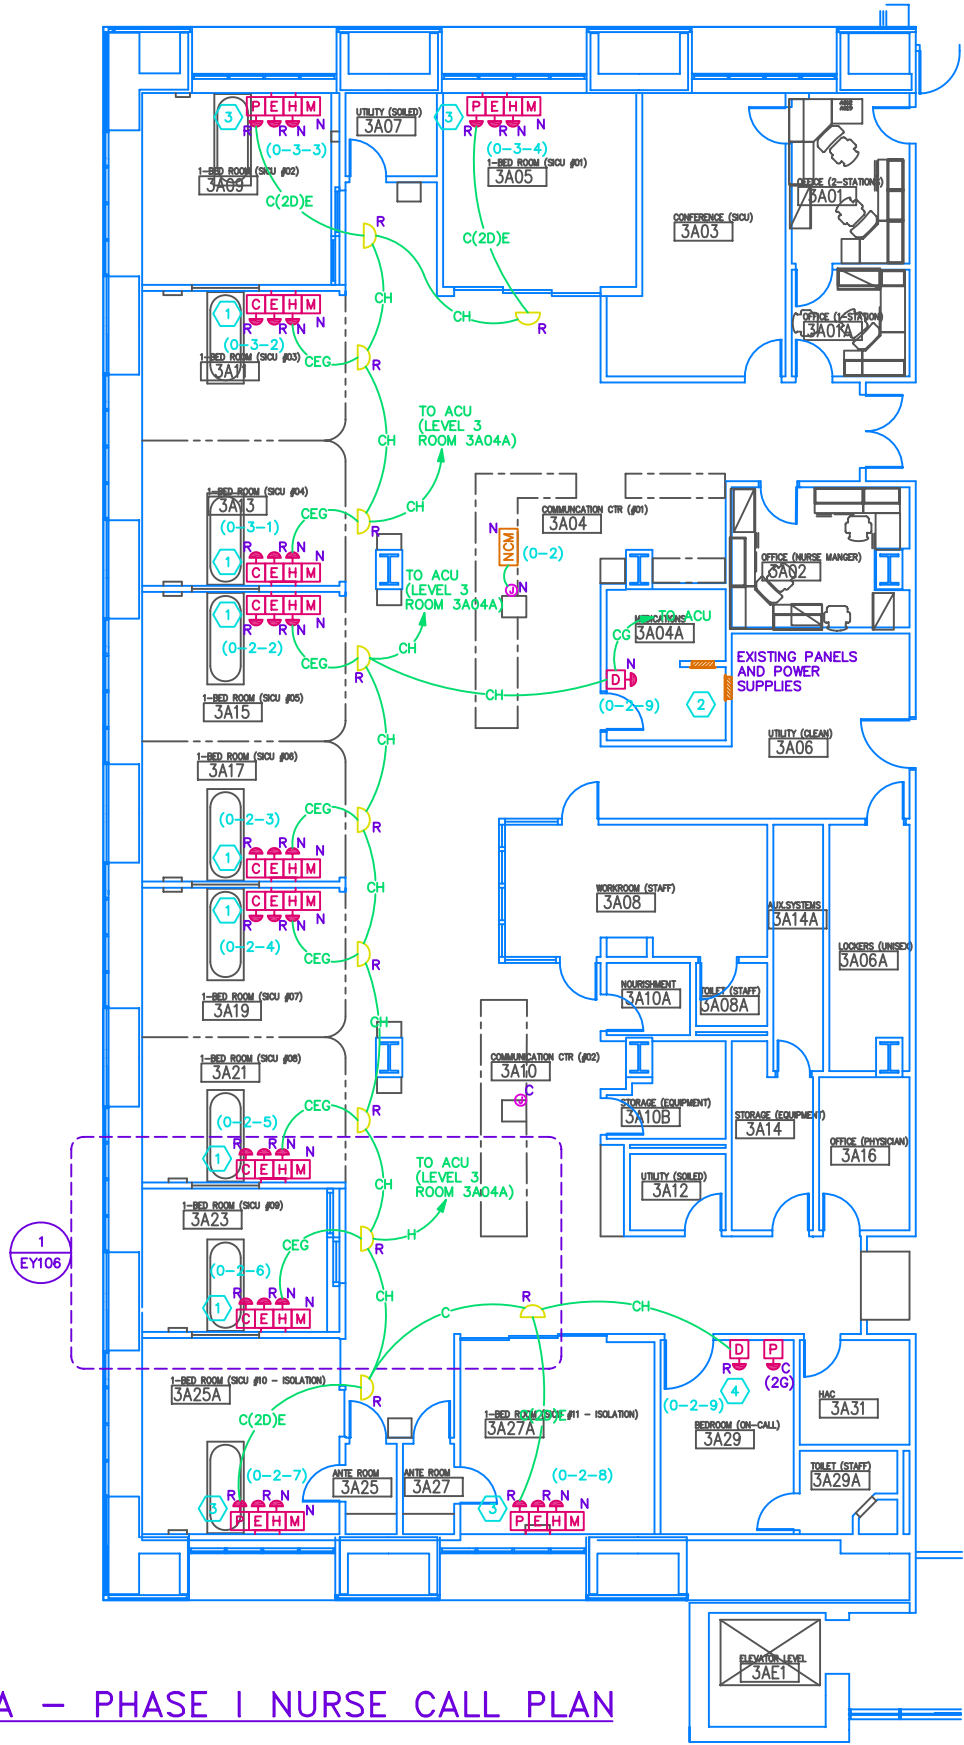


SICU AREA – PHASE I NURSE CALL PLAN  
SCALE: 1/8"=1'-0"

### SHEET KEYNOTES

1. PROVIDE ADAPTER PLATE FOR 4 EA NEW 1G DEVICES ON EXISTING HEADWALL COLUMN.
2. UTILIZE EXISTING NURSE CALL CABINET FOR NEW AREA CONTROL UNIT AND POWER SUPPLIES.
3. PROVIDE ADPATOR PLATE FOR 3 EA NEW 1G DEVICE AND 3 EA NEW 1G DEVICES ON EXISTING HEADWALL COLUMN.
4. PROVIDE 11" x 5" ADAPTOR PLATE FOR NEW DUTY STATION.

### GENERAL SHEET NOTES

1. REPLACE EXISTING DUKANE NURSE CALL SYSTEM DEVICES AND PROVIDE ADDITIONAL NEW DEVICES AS INDICATED. PROVIDE NEW BOXES, RACEWAYS, AND CABLES AS REQUIRED. UTILIZE EXISTING CABLE TRAYS.

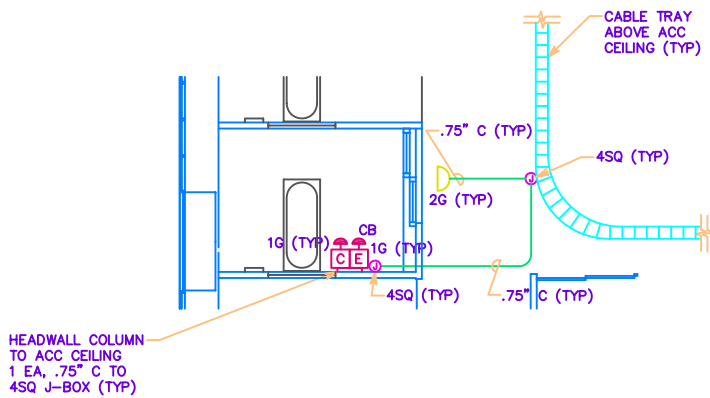

1 PATIENT ROOM RACEWAY DETAIL – TYPICAL  
EY106 SCALE: 1/8"=1'-0"

Revisions

Date

CADD Information

Drawing Title

Project Title

Date

Project No.

Approved

Approved Medical Center Director

Drawn

MEI

Building Number

B.14 – THIRD FLOOR

DRAWING No.

EY106

Approved

Approved Chief, Engineering

Checked

RPN

Location

VAMC, SLC UTAH

Dwg. OF

Department of  
Veterans Affairs






1 PATIENT ROOM RACEWAY DETAIL – TYPICAL  
EY104 SCALE: 1/8"=1'-0"


Revisions			CADD Information	Drawing Title  MICU AREA	Project Title  NURSE CALL UPGRADE AS-BUILT DRAWINGS	Date 03/18/05
			Approved:	Approved: Medical Center Director	Drawn MEI	Project No.
			Approved:	Approved: Chief, Engineering	Checked RPN	BUILDING Number B.14 – SECOND FLOOR
	Date				Location VAMC, SLC UTAH	DRAWING No. EY104
					Dwg. OF	

Department of Veterans Affairs



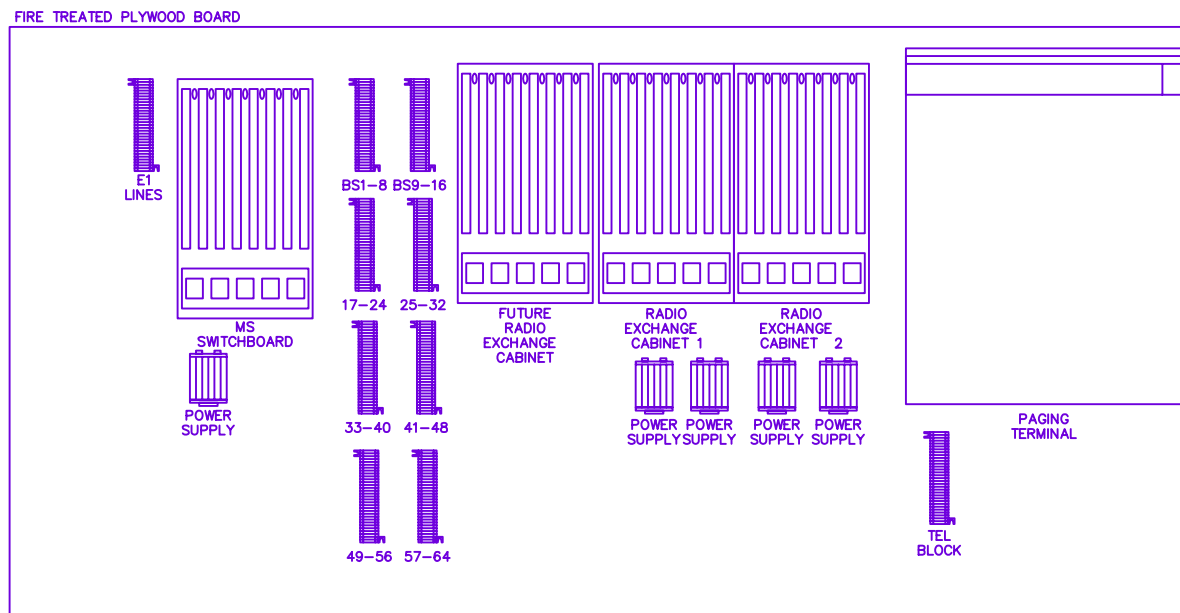

## 2 WIRELESS TELEPHONE BOARD ELEVATION DETAIL

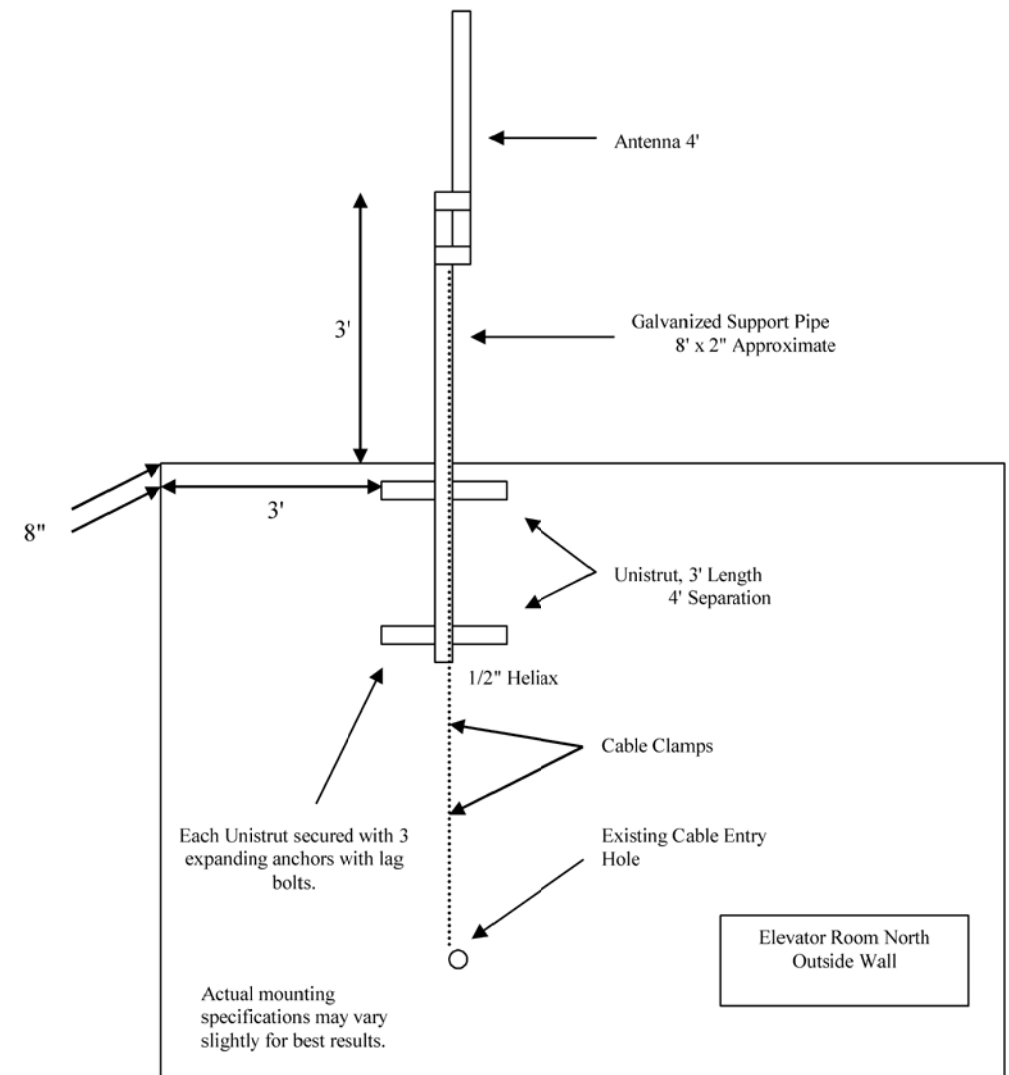

## 1 WIRELESS PAGING ANTENNA MOUNTING DETAIL

Revisions				Drawing Title NURSE CALL COMMUNICATIONS DETAILS	Project Title NURSE CALL UPGRADE AS-BUILT DRAWINGS	Date 03/18/06
			Approved:	Approved Medical Center Director MEI	Building Number	DRAWING No. EY603
			Approved:	Approved Chief, Engineering RPN	Location VAMC, SLC UTAH	Dwg. Of